

**CITY OF HASTINGS, NEBRASKA
ADDENDUM NO. 1, 11-26-25
480V SWITCHGEAR INSTALLATION
NORTH DENVER STATION UNIT 5
Contract No. HU 2025-140**

This addendum document must be signed and submitted with your bid package.

The following bid sections were updated accordingly:

- Section 3.1 – General – *Changed the point of contact for the project.*
- Section 3.4 – Scope of Work/Technical Specification:
 - o *Clarified that Hastings Utilities will be handling the lifting, moving, and rigging.*
 - o *Clarified that the Contractor will need to support the cable tray*
 - o *Clarified that the Contractor will be responsible to remove and reinstall the buss bar splice in the middle section*
 - o *Clarified that any wire length issues will be handled on a change order basis and on a case-by-case basis for remedy method.*

Provided the following information with this addendum:

- *Original construction drawings of the existing gear*
- *One Line drawings of the existing 480V switchgear*
- *Existing Transformer Drawings*

CITY OF HASTINGS

By Derek Pfeifer

Title Production Engineer

The undersigned bidder hereby certifies that the revision set forth in this addendum have been incorporated in their bid and are a part of the contract documents.

Signed _____

Title _____

Firm _____

Date _____

**ALL ISSUED ADDENDUM(S) MUST BE ACKNOWLEDGED
& RETURNED WITH YOUR BID DOCUMENTS**

SECTION 3 – SCOPE OF WORK & TECHNICAL SPECIFICATION

SECTION 3-0 SCOPE OF WORK & TECHNICAL SPECIFICATION

3.1 General

The City of Hastings (“Hastings”) is accepting bids for the removal of existing 480V switchgear and installation of replacement switchgear for the North Denver Generator #5 in Hastings, Nebraska.

The Bidder is **REQUIRED** to visit the site prior to submitting a bid to ensure that the bidder can complete the switchgear replacement within the outage dates. The Bidder shall inform himself of all conditions and factors which would affect the execution of the work. No claims for financial compensation or time extension, based on the lack of such prior information (or its effect on the cost of the work) will be permitted by the Owner. Please contact ~~Nathan Bren, Electrical Engineer, at 402-462-3652~~ **Derek Pfeifer, Production Engineer at 402-463-3676** if you have any questions about this project or to set up a visit.

The Owner is recommending that the Bidder provide plenty of time for the bid packages to arrive. There have been multiple bids recently that were not delivered on time due to the shipping companies’ delays. Please ensure the bids are mailed with adequate time. They will be promptly opened at 1:30pm on the bid opening day, and late bids cannot be considered.

3.2 Schedule

This shall include the completion of various activities in accordance with the milestone time periods and dates listed. The Contractor shall submit a preliminary project schedule including existing switchgear removal, new switchgear installation, and electrical connections.

Major Milestone Schedule:

Activity	Schedule
Bid Opening	Friday, December 12, 2025
Contract Award Date	Anticipated – December 19, 2025
Outage Start Date – Start of Work	January 4, 2026
Eaton Switchgear Testing – Electrical Connections Due	January 27, 2026
Outage End Date – Completion Due	January 31, 2026

3.3 Site Description

The new switchgear will occupy the same footprint as the existing switchgear, located in the basement of the North Denver Station (NDS) plant, located adjacent to the City of Hastings office buildings at 1228 N. Denver Ave.

3.4 Scope of Work/Technical Specification

3.4.1 Remove Existing Switchgear

- Remove existing gear while preserving all existing cables.

- Modification of cable trays, conduit, and power cables may be necessary.
- ~~COH can provide assistance by operating overhead crane to lift switchgear from basement to ground floor if necessary.~~ COH will handle all rigging, transporting, and lifting of the new and existing gear. COH will be responsible to remove the floor grating and structural steel, remove the water and air lines, move the existing and new gear, lower the new gear to the basement, and raise the existing gear to the first floor.
- Contractor will be responsible to support the existing cable tray during construction. The cable tray is welded to the top of the existing gear.
- ~~COH will provide a trailer for the switchgear to be placed on.~~ COH will handle getting the existing gear to the first floor and disposal.
- COH will de-energize gear and provide a spot for Contractor to place a lock for LOTO. Some control wiring may still be energized.

3.4.2 Move New Gear – COH scope

- ~~Lower new switchgear from ground floor to basement. COH will remove piping and steel that is blocking the path.~~
- ~~COH can provide assistance by operating overhead crane to lower switchgear to basement. Contractor will be responsible for rigging switchgear sections for lifting.~~
- ~~Move new switchgear into place.~~
- ~~Contractor will supply any other equipment required to move switchgear sections.~~
- Contractor will need to remove the buss bar splice plate off the middle section of new gear to permit sliding the three sections together.

3.4.3 Install New Switchgear (Eaton Magnum PXR UL switchgear, split in 3 sections)

- See attached document (NDS 5 Eaton Switchgear Drawings - Final 2025-10-20.pdf)
- Provide all equipment and materials necessary for installation.
- Perform all necessary steps to fasten switchgears sections together
- Note from Eaton: Contractor may need to drill the mounting holes during the SWGR installation.
- Connect new switchgear bus to existing transformers. Eaton placed a small cutout in the side sheet for the transformer connections to go through, Contractor will have to drill bolt holes for the connection.
- COH will perform necessary concrete work before work is scheduled to begin. This includes adding to base due to increased switchgear size and removing section of berm to allow easier access to switchgear. This has been completed and is ready for the contractor.

3.4.4 Reconnect existing cables

- Provide and perform all necessary raceway and conduit modification.
- Reconnect existing cables to new breakers.
- If the existing cables are too short, the chosen remedy will be decided between COH electrical supervisor and the Contractor, and will be handled on a change order basis.

3.4.5 Installed equipment must meet NFPA 70 - National Electric Code (NEC) and all other applicable codes and standards.

3.4.6 Examination of Sites

Each respondent is considered to have examined the work site to fully acquaint itself with the exact existing conditions relating to the work and to fully understand the work involved

and the difficulties and restrictions regarding the proposed work. The submission of a bid will be considered as conclusive evidence that the respondent has made such examination.

3.5 Work Not Included Under These Specifications

3.5.1 Switchgear procurement

3.5.2 Concrete work

3.5.3 Old Switchgear Disposal


3.5.4 Commissioning Testing – To be done by Eaton in last 3 or 4 days of outage.

3.5.5 Lifting, moving, or rigging the existing and new gear

3.6 Attachments

- NDS 5 Eaton Switchgear Drawings - Final 2025-10-20.pdf

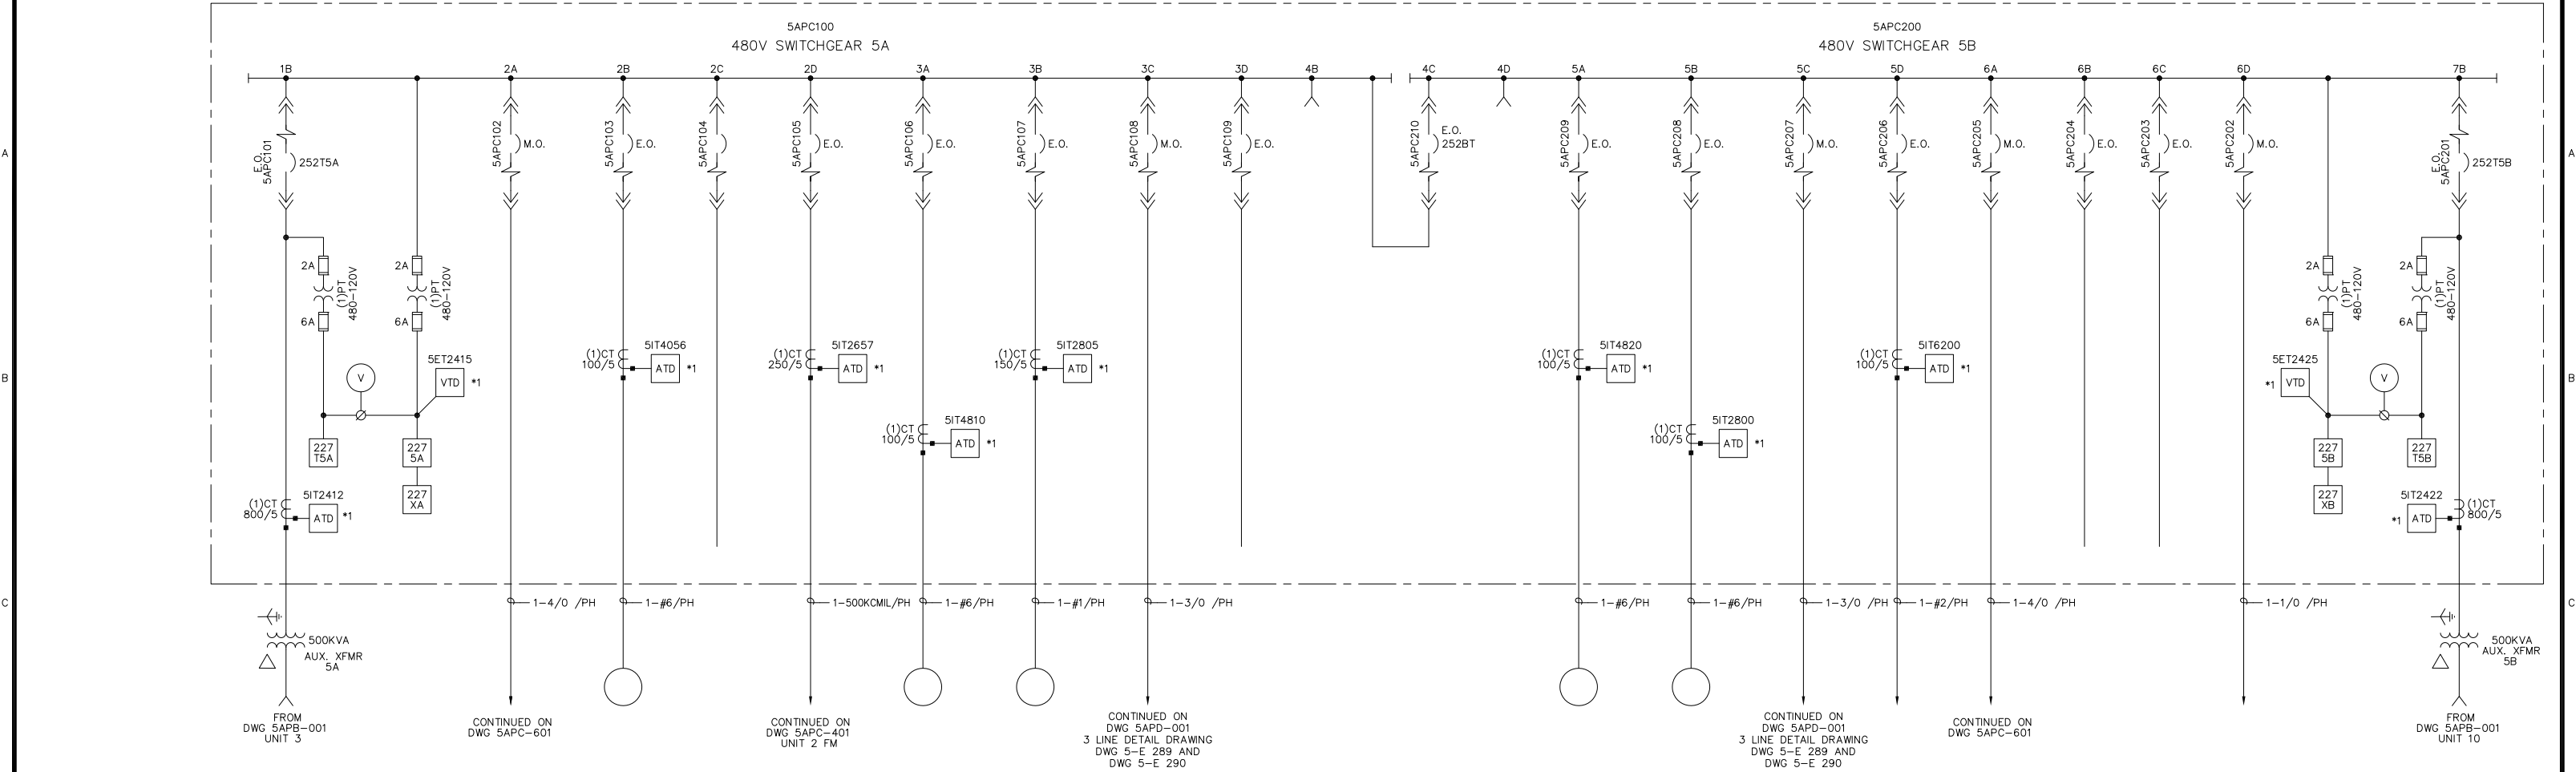CURRENT ONE LINE DRAWING



BREAKER SCHEM DIAG	5APC-002			5APC-005		5APC-006	5APC-007	5APC-009	5-E 289			5APC-004		5APC-008	5APC-010	5-E 289	5APC-011					5APC-003	
WIRING DIAG	5APC-002			5APC-005		5APC-006	5APC-007	5APC-009	5-E 286			5APC-004		5APC-008	5APC-010	5-E 270	5APC-011					5APC-003	
A.C.B. RATINGS AMP	800		225	70	40	225	90	125	225	90		500		90	90	225	90	225	40	40	150	800	
LOAD RATING HP OR KVA	500KVA			30		150	40	75	150KVA					40	40	150KVA						500KVA	
SERVICE	AUXILIARY XFMR 5A 2400-480V	POT XFMR COMPT	TURB RM MCC	TURB AUX OIL PUMP	UNASSIGNED	EMERG FEED COOLING TOWER	CONDENSATE PUMP 5-1	U5 STATION AIR COMPRESSOR (NEW ATLAS COPCO)	LIGHTING XFMR 5-A	SPARE	FUTURE	BUS TIE	SPARE	CONDENSATE PUMP 5-2	INSTRUMENT AIR COMPR 5A (PENNSYLVANIA)	LIGHTING XFMR 5-B	OIL PUMP HOUSE	BOILER RM MCC	FUTURE	SPARE	WELDER RECEPTACLES	POT XFMR COMPT	AUXILIARY XFMR 5B 2400-480V
DWG 5APC-601												DWG 5APC-601											

REFERENCE DRAWINGS:

*1 5APC-015

SUPERSEDES PART OF DWG. E-206, DATED 1-3-67



UNIT 5 - 480V SWITCHGEAR ONE-LINE DIAGRAM










Temporary Permit to Practice Engineering in Nebraska
Mr. Glenn E. Milkert (Electrical)
Permit No.: T0127; Expiration Date: 12/1/2001
State of Licensure: Missouri; No. E-13956
Project: Hastings Utilities, Units 4&5 Control Systems Upgrade



STILWELL, KANSAS
99475607

Rev. 7

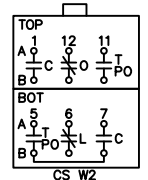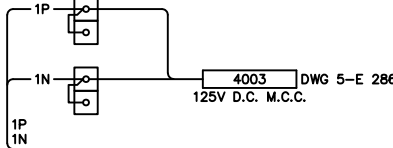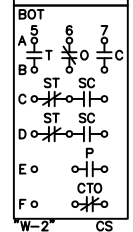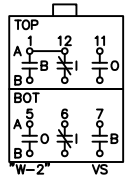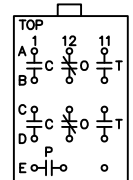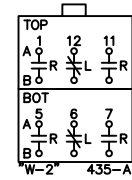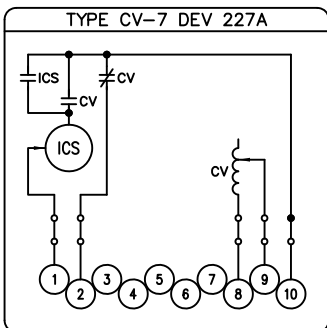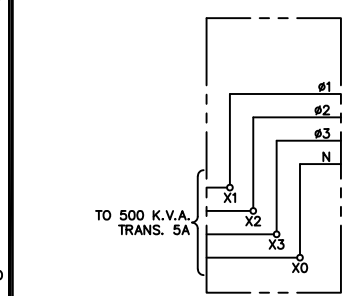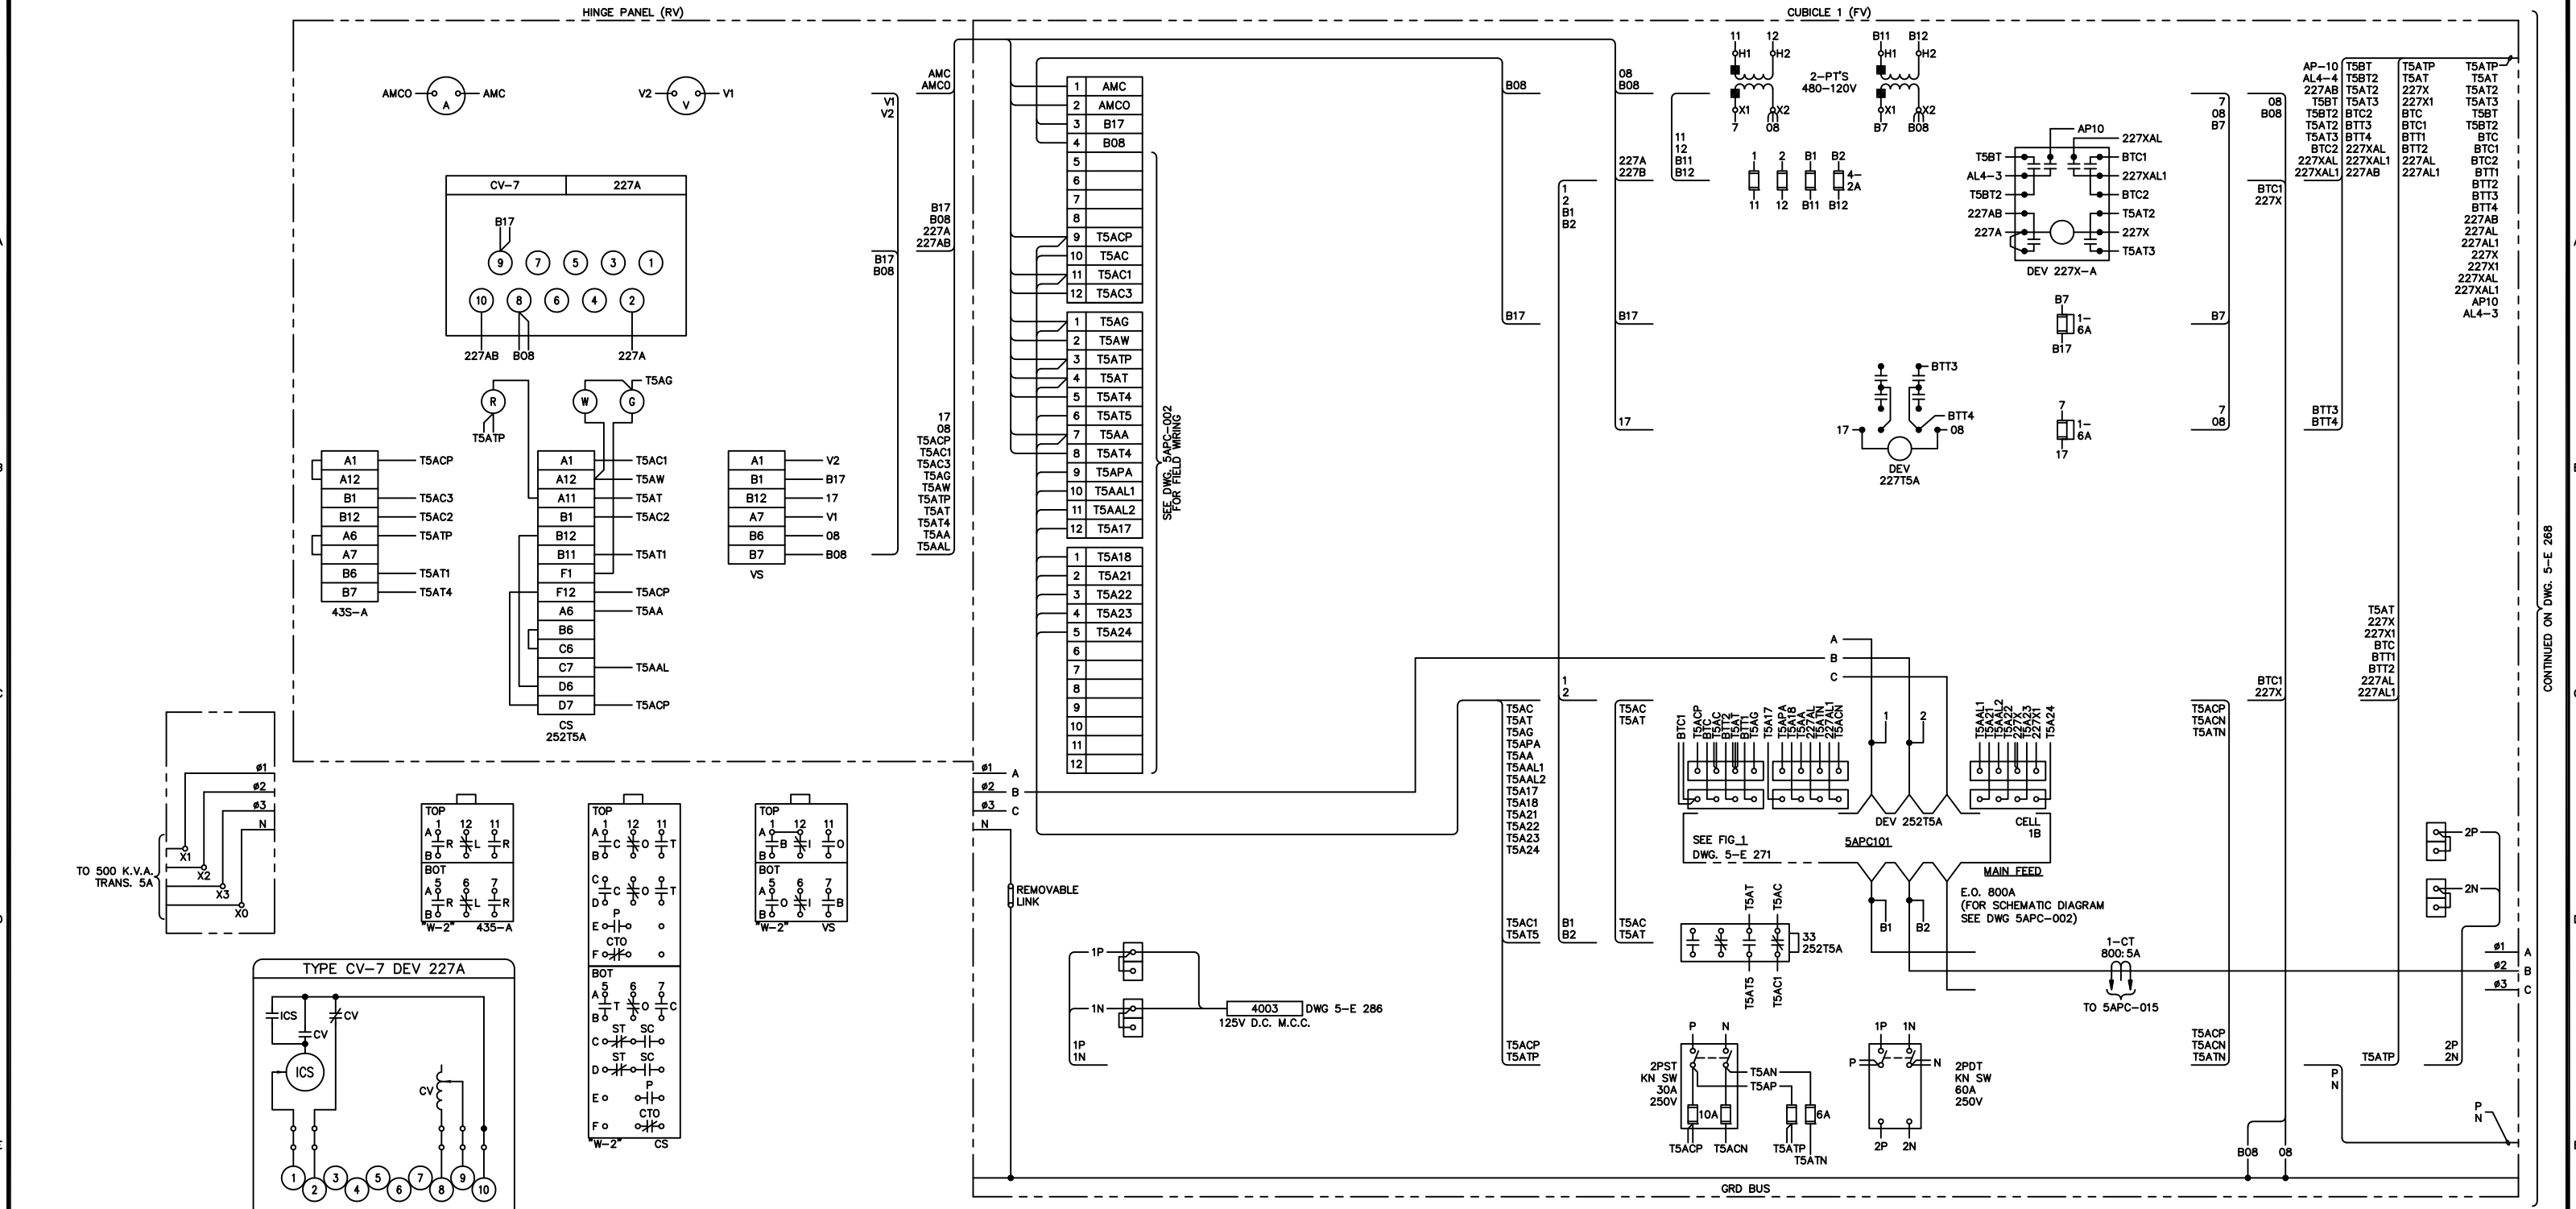5APC-001



REFERENCE DRAWINGS:
5APC-001 480V SWGR ONE-LINE DIAGRAM

SUPERSEDES DRAWING: E 267, REV. B, DATED: 5-22-67



UNIT 5
480V SW. GR.-CUB. 1
WIRING DIAGRAM

CURRENT ONE LINE DRAWING

NO	DATE	REVISIONS	DWN	CK	ACC	APP	NO	DATE	REVISIONS	DWN	CK	ACC	APP
1	7-11-06	AS-BUILT					1	7-11-06	AS-BUILT				
2	8-30-01	CONFORMING TO CONSTRUCTION RECORDS					2	8-30-01	CONFORMING TO CONSTRUCTION RECORDS				



Rev. 1

5-E 267

CURRENT ONE LINE DRAWING

NO	DATE	REVISIONS	DWN	CK	ACC	APP	NO	DATE	REVISIONS	DWN	CK	ACC	APP
1	7-11-06	CHANGED "LTG. TRANS. 5-1" TO 5-A					1	7-11-06	CHANGED "LTG. TRANS. 5-1" TO 5-A	SH			
0	8-30-01	CONFORMING TO CONSTRUCTION RECORDS					0	8-30-01	CONFORMING TO CONSTRUCTION RECORDS	YCP	JDC		AMA

REFERENCE DRAWINGS:
5APC-001 480V SWGR ONE-LINE DIAGRAM


Sega
STILWELL, KANSAS
99475825

SUPERSEDES DRAWING: E 268, REV. C, DATED: 12-10-68

HU Hastings Utilities **HU**
North Denver Station

UNIT 5
480V SW. GR.-CUB. 2 & 3
WIRING DIAGRAM

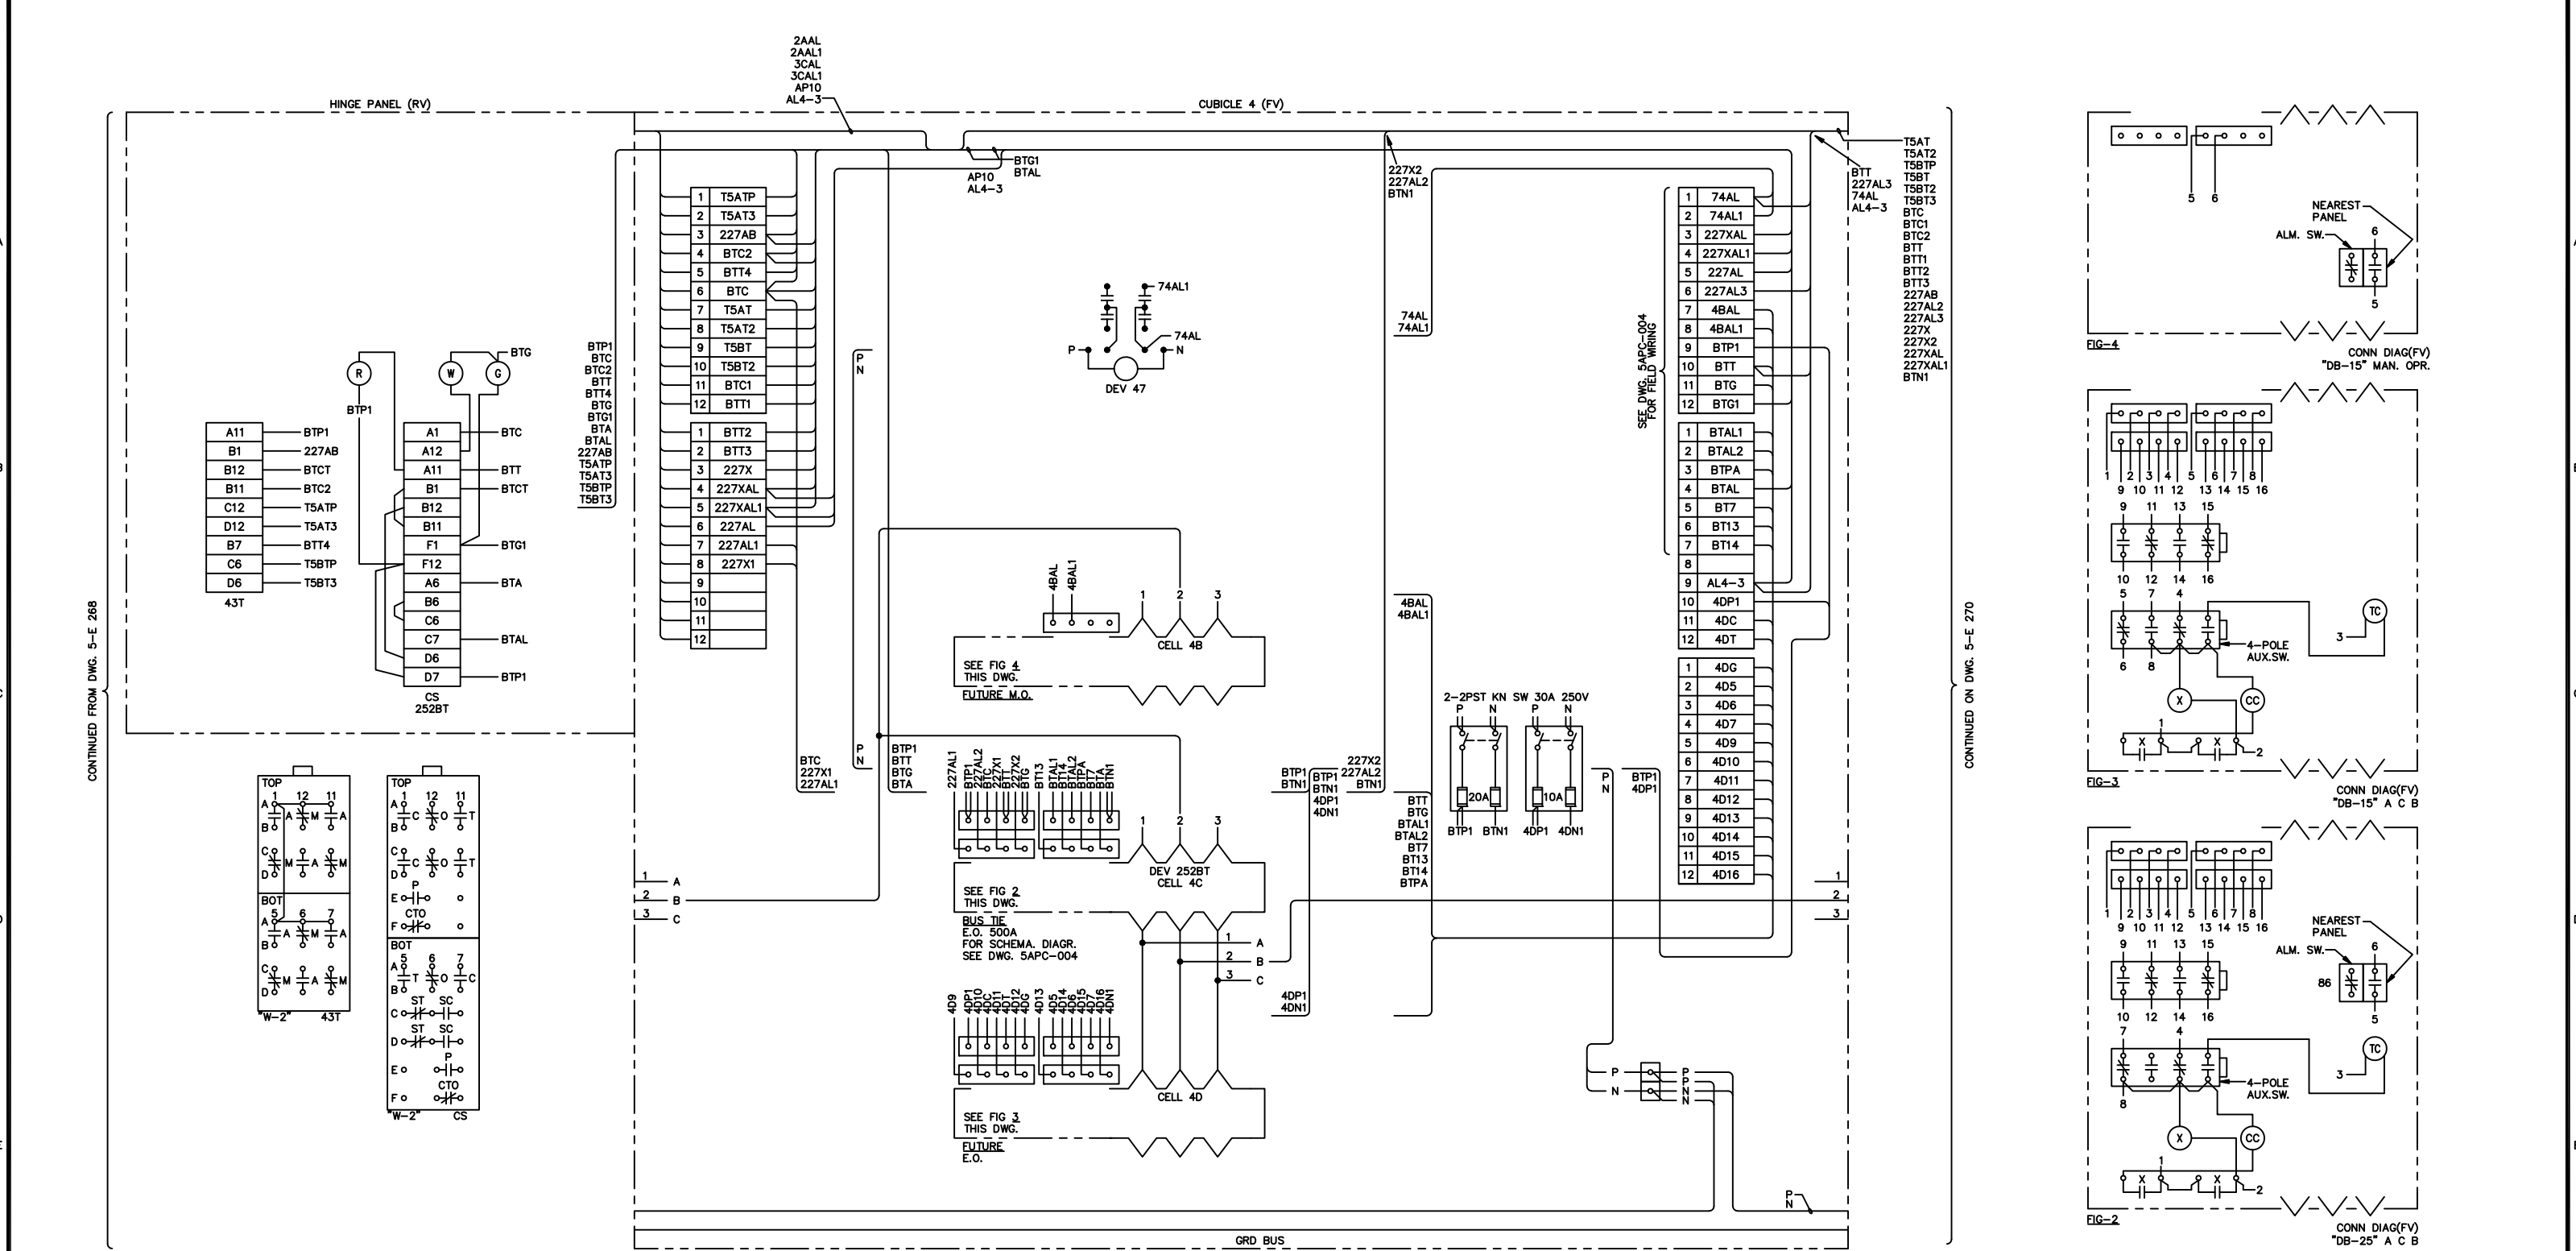Rev. 1
5-E 268



CONTINUED FROM DWG. 5-E 268

CONTINUED ON DWG. 5-E 270

REFERENCE DRAWINGS:
5APC-001 480V SWGR ONE-LINE DIAGRAM

SUPERSEDES DRAWING: E 269, REV. B, DATED: 5-22-67



UNIT 5
480V SW. GR.-CUB. 4
WIRING DIAGRAM

CURRENT ONE LINE DRAWING


NO	DATE	REVISIONS	DWN	CK	ACC	APP	NO	DATE	REVISIONS	DWN	CK	ACC	APP
							0	8-30-01	CONFORMING TO CONSTRUCTION RECORDS	YCP	JDC		AMA



STILWELL, KANSAS
99475826

Rev. 0

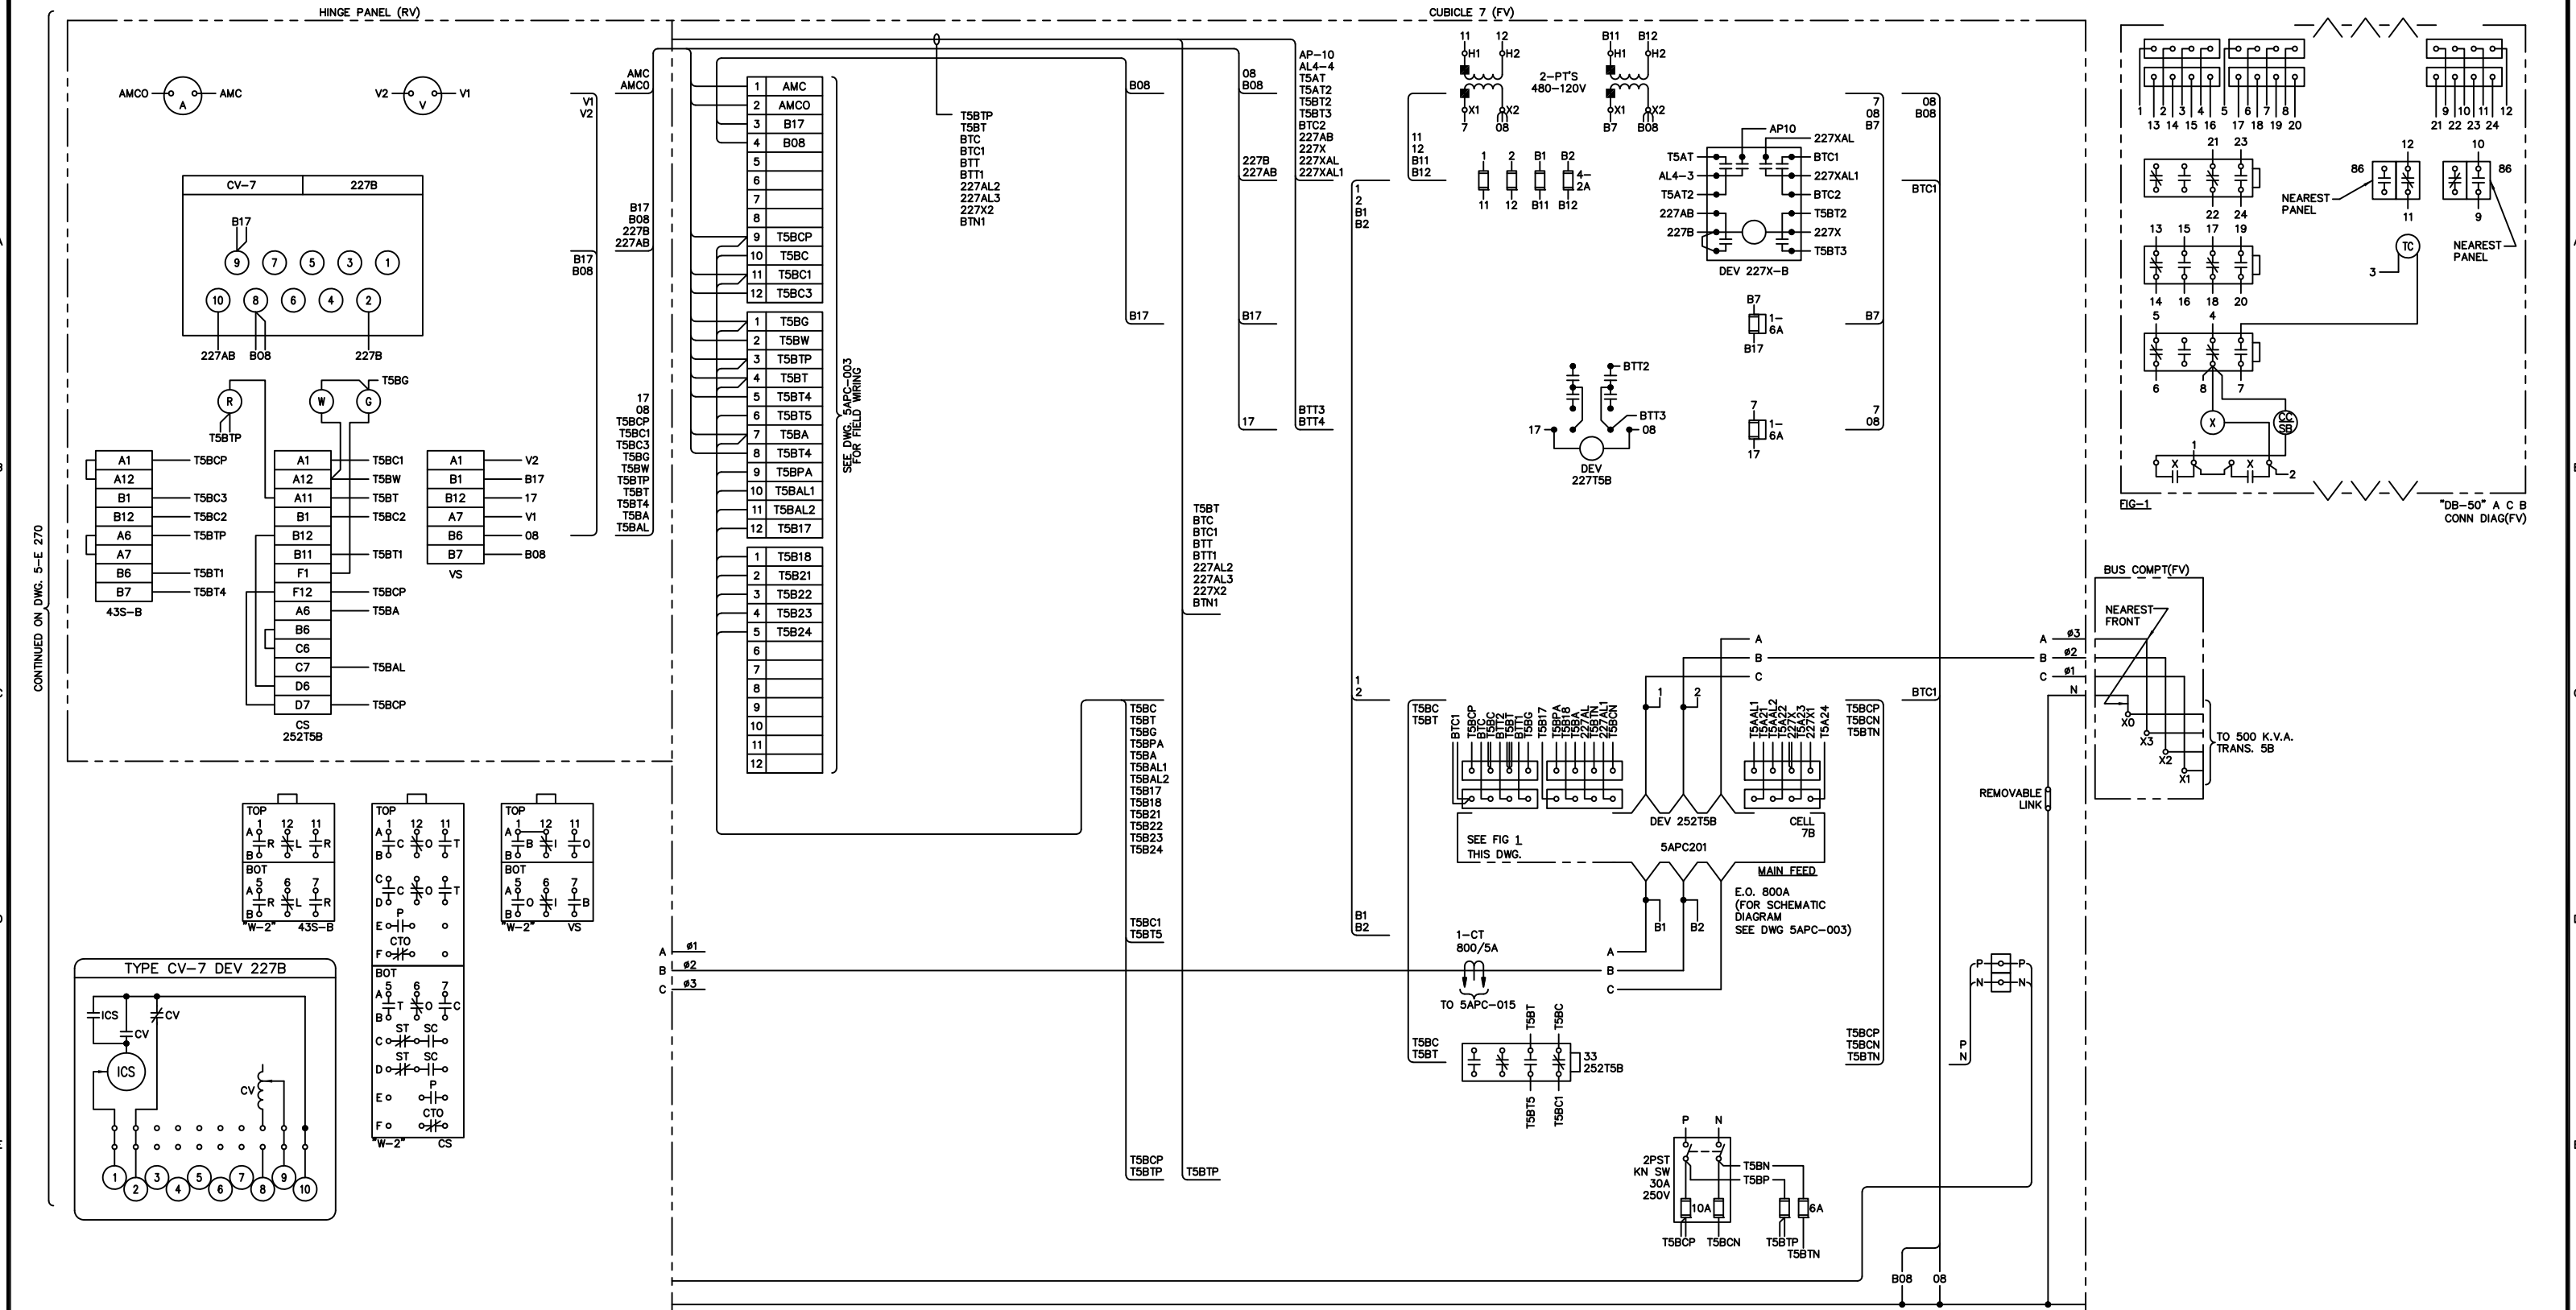5-E 269



CURRENT ONE LINE DRAWING

REFERENCE DRAWINGS:
5APC-001 480V SWGR ONE-LINE DIAGRAM



Hastings Utilities
North Denver Station




UNIT 5
480V SW. GR.-CUB. 7
WIRING DIAGRAM

Rev. 0

5-E 271

NO	DATE	REVISIONS	DWN	CK	ACC	APP	NO	DATE	REVISIONS	DWN	CK	ACC	APP
							0	8-30-01	CONFORMING TO CONSTRUCTION RECORDS	YCP	JDC	AMA	

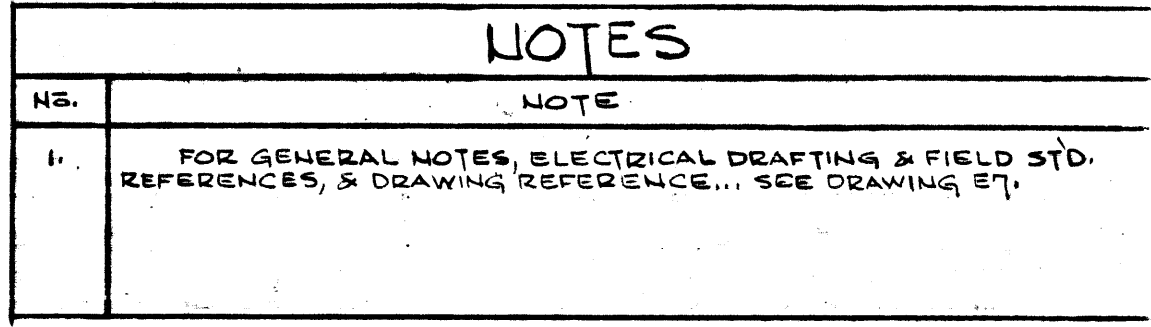
STILWELL, KANSAS
99475809



SARGENT & LUNDY
ENGINEERS
CHICAGO 3, ILLINOIS

DRAWING NO.

E 8


134D249

ALUM. BUS & RISERS					
SYM.	SIZE	SYM.	SIZE	SYM.	SIZE
A	1/4 X 6	E	1/4 X 3	I	1/4 X 1-1/2
B	1/4 X 5	F	1/4 X 2-1/2	J	1/4 X 1-1/4
C	1/4 X 4	G	1/4 X 2	K	1/4 X 1
D	1/4 X 3-1/2	H	1/4 X 1-3/4		


NOTE - NUMERICAL SUFFIX ADDED TO BUS SYMBOL INDICATES NO. OF BARS PER PHASE.

TERMINAL APPLICATION DATA					
MAIN LEADS			NEUTRAL LEADS		
CIRCUIT NO.	TERMS PER PH.	CABLE SIZE	B. OF M. ITEM	NO. OF CABLES	B. OF M. ITEM
702	1	4/0	102		
703	1	4/0	102		
704	1	4/0	102		
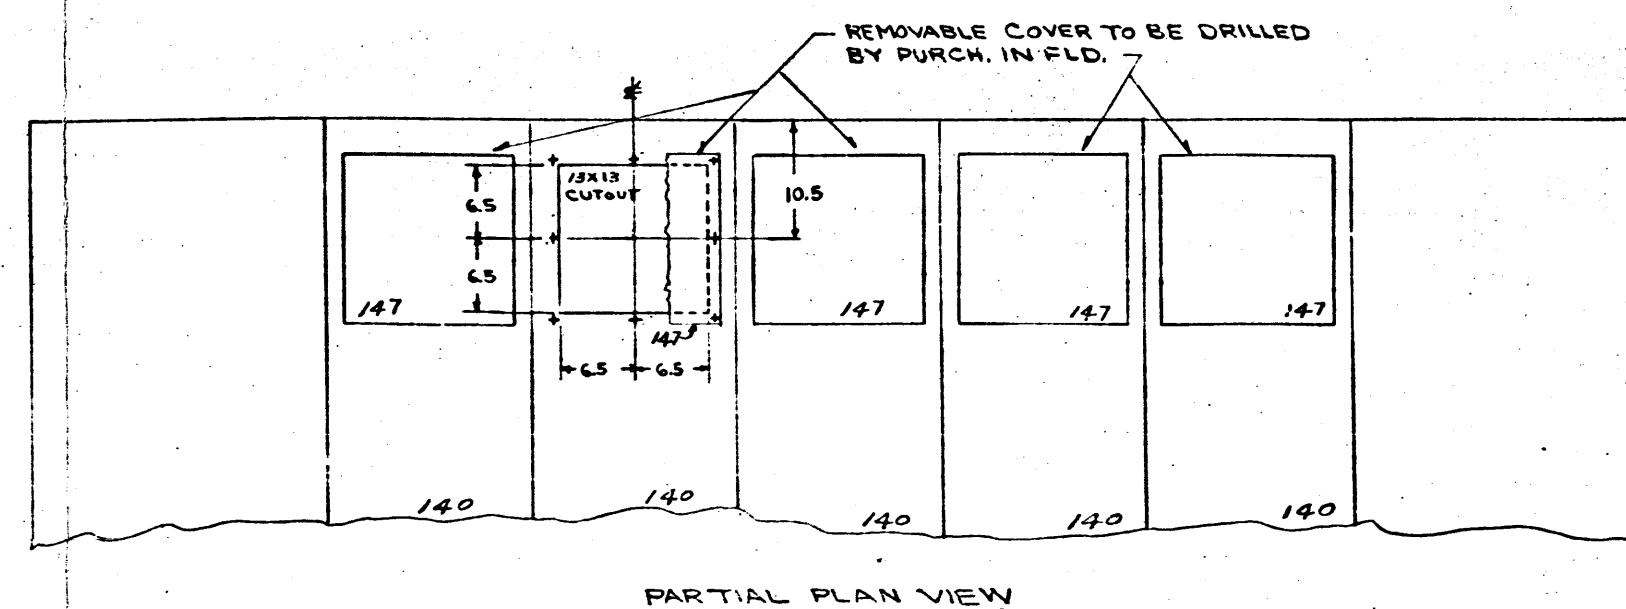A - FUTURE




PARTIAL PLAN VIEW

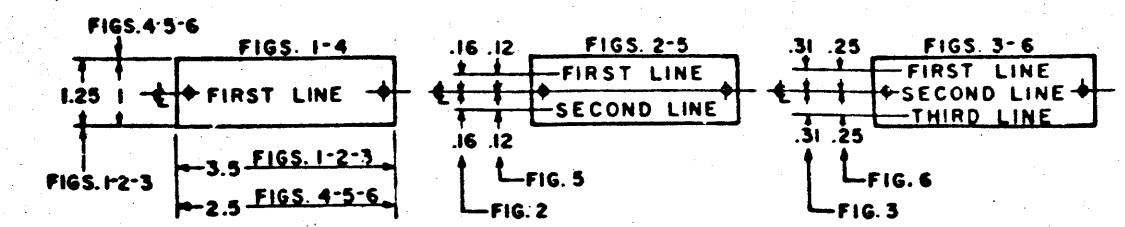







NP	IT. NO.	B. OF M.	FIRST LINE	SECOND LINE	THIRD LINE	LET.	NO.	REQ.
701	70		MAIN ACB	480V. BUS 5A			130	1
702			TURBINE ROOM	MCC			2	1
703			TURBINE AUX.	OIL PUMP			2	1
704			COOLING TOWER	EMERG. FEED			2	1
705			CONDENSATE	PUMP 5-1			2	1
706			STATION AIR	COMPRESSOR			2	1
707			LIGHTING	TRANS. 5A			2	1
708								
709								
710			TIE ACB				1	1
711								
712			CONDENSATE	PUMP 5-2			2	1
713			CONTROL AIR	COMPRESSOR			2	1
714			LIGHTING	TRANS. 5D			2	1
715								
716			B.R. MCC				1	1
717								
718								
719			WELDER FEED				1	1
720			MAIN ACB	480V. BUS 5B			2	1
721	69		MAIN ACB	480V. BUS 5A			2	1
722			TIE				2	1
723			MAIN	480V. BUS 5B			2	1
724								
725			MAIN ACB	480V. BUS 5A			2	1
726			INCOMING	D.C. SUPPLY			2	1
727			TURBINE AUX.	OIL PUMP			2	1
728								
729			COOLING TOWER	EMERG. FEED			2	1
730			CONDENSATE	PUMP 5-1			2	1
731			STATION AIR	COMPRESSOR			2	1
732								
733			TIE ACB				4	1
734								
735			CONDENSATE	PUMP 5-2			2	1
736			CONTROL AIR	COMPRESSOR			2	1
737								
738								
739			MAIN ACB	480V. BUS 5B			2	1
740								
741								

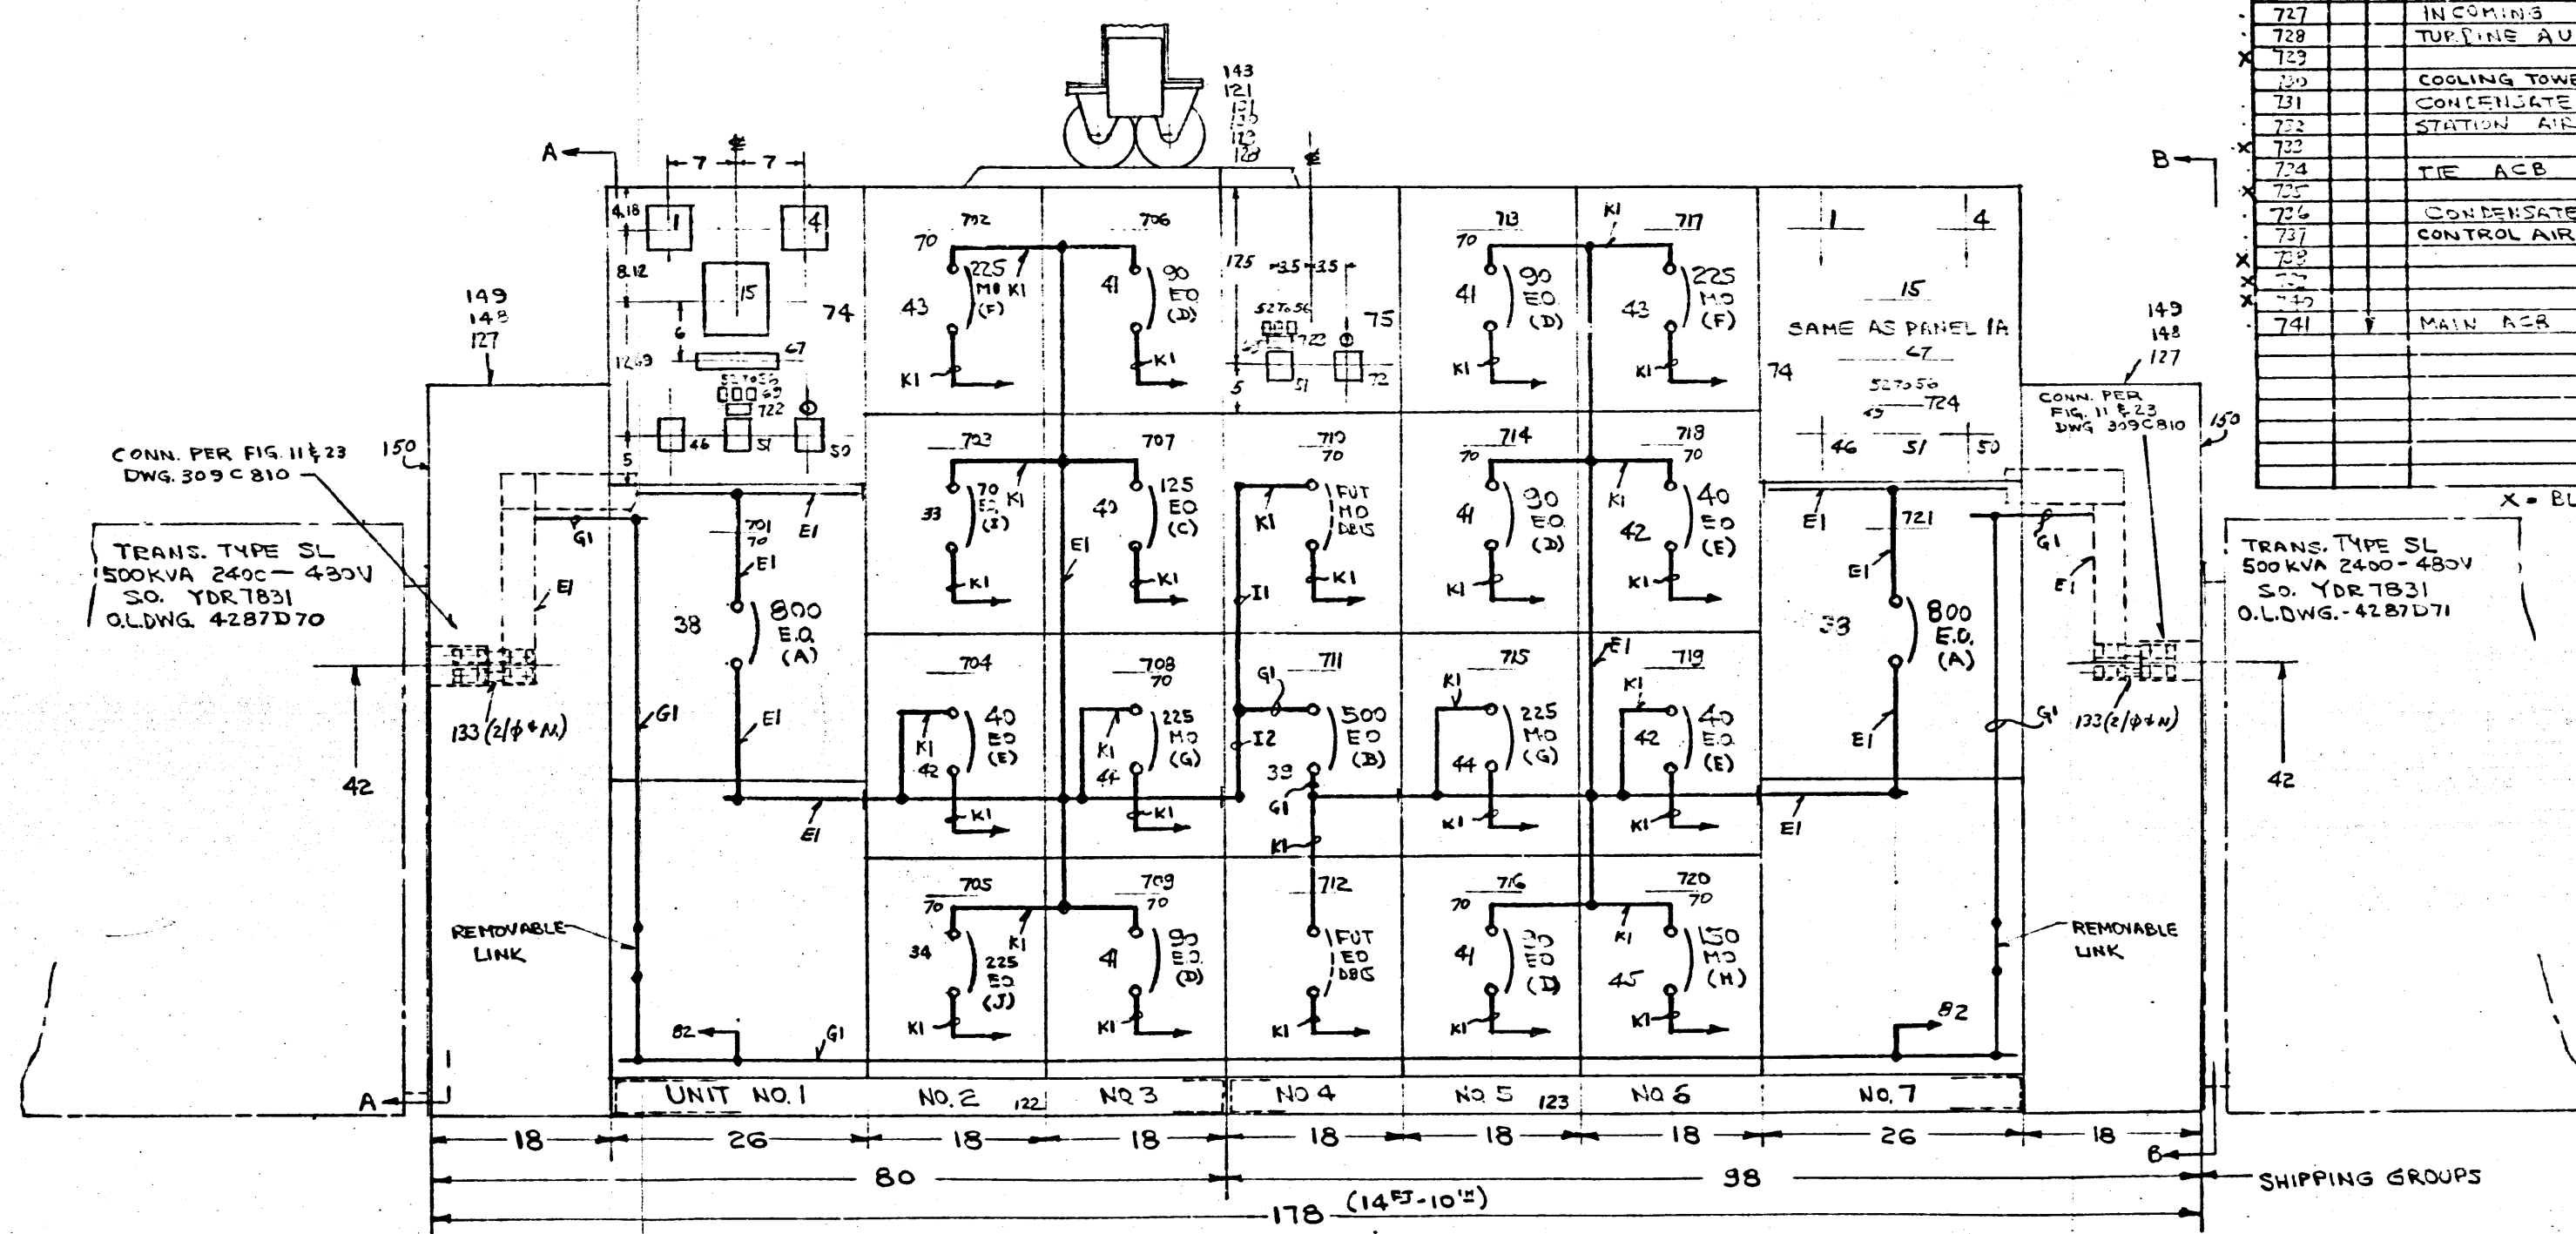X = BLANK





1
24-1-4120
10.01/250 JVE
11
12
13
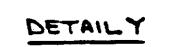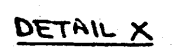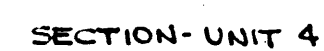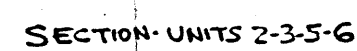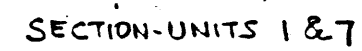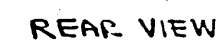WESTINGHOUSE ELECTRIC CORPORATION
HASTINGS UTILITIES
LOW VOLTAGE METAL ENCLOSED SWGR.
DIMENSIONS IN INCHES-SCALE
DATE 11/20/01 BY J. N. Hunter
134D249
DIVISION SWGR. PLANT LOCATION EAST PITTSBURGH 4600




FORM 31957 A

134D250 ENCLOSURE DIVISION SWGR	WESTINGHOUSE ELECTRIC CORPORATION			
	TITLE <u>HASTINGS UTILITIES</u>		HASTINGS, NEBRASKA	
	LOW VOLTAGE METAL ENCLOSED SWGR			
	DIMENSIONS IN INCHES-SCALE		ASSEMBLY - SECTION 2 & 3	
	DFTM <u>1/2" = 1'-0"</u>		<u>1/2" = 1'-0"</u>	
DIVISION <u>SWGR</u>		PLANT LOCATION <u>EAST PATTERSON, PA</u>		
2		3		

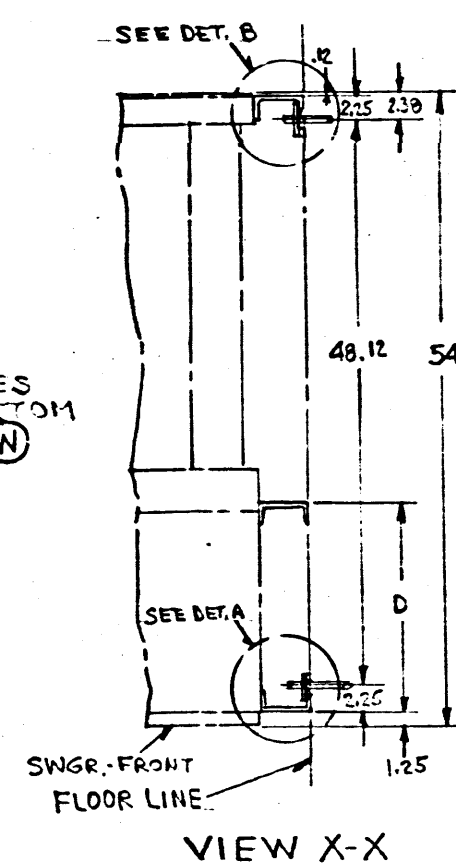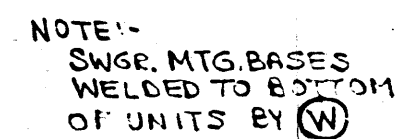


BKR TYPE	UNIT WIDTH	A	B	C	D	UNIT NO.S
DE25	18	21	7.44	36	1325	2 TO 6
DB50	26	21	11.44	44	1350	1 & 7

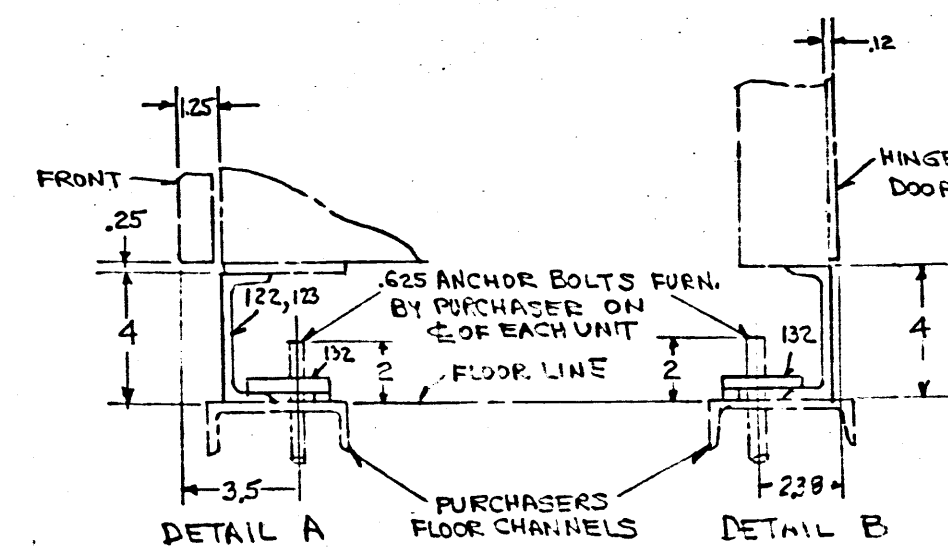

NOTE: FOR B/W IT. NOS, SEE DWG. 681C006

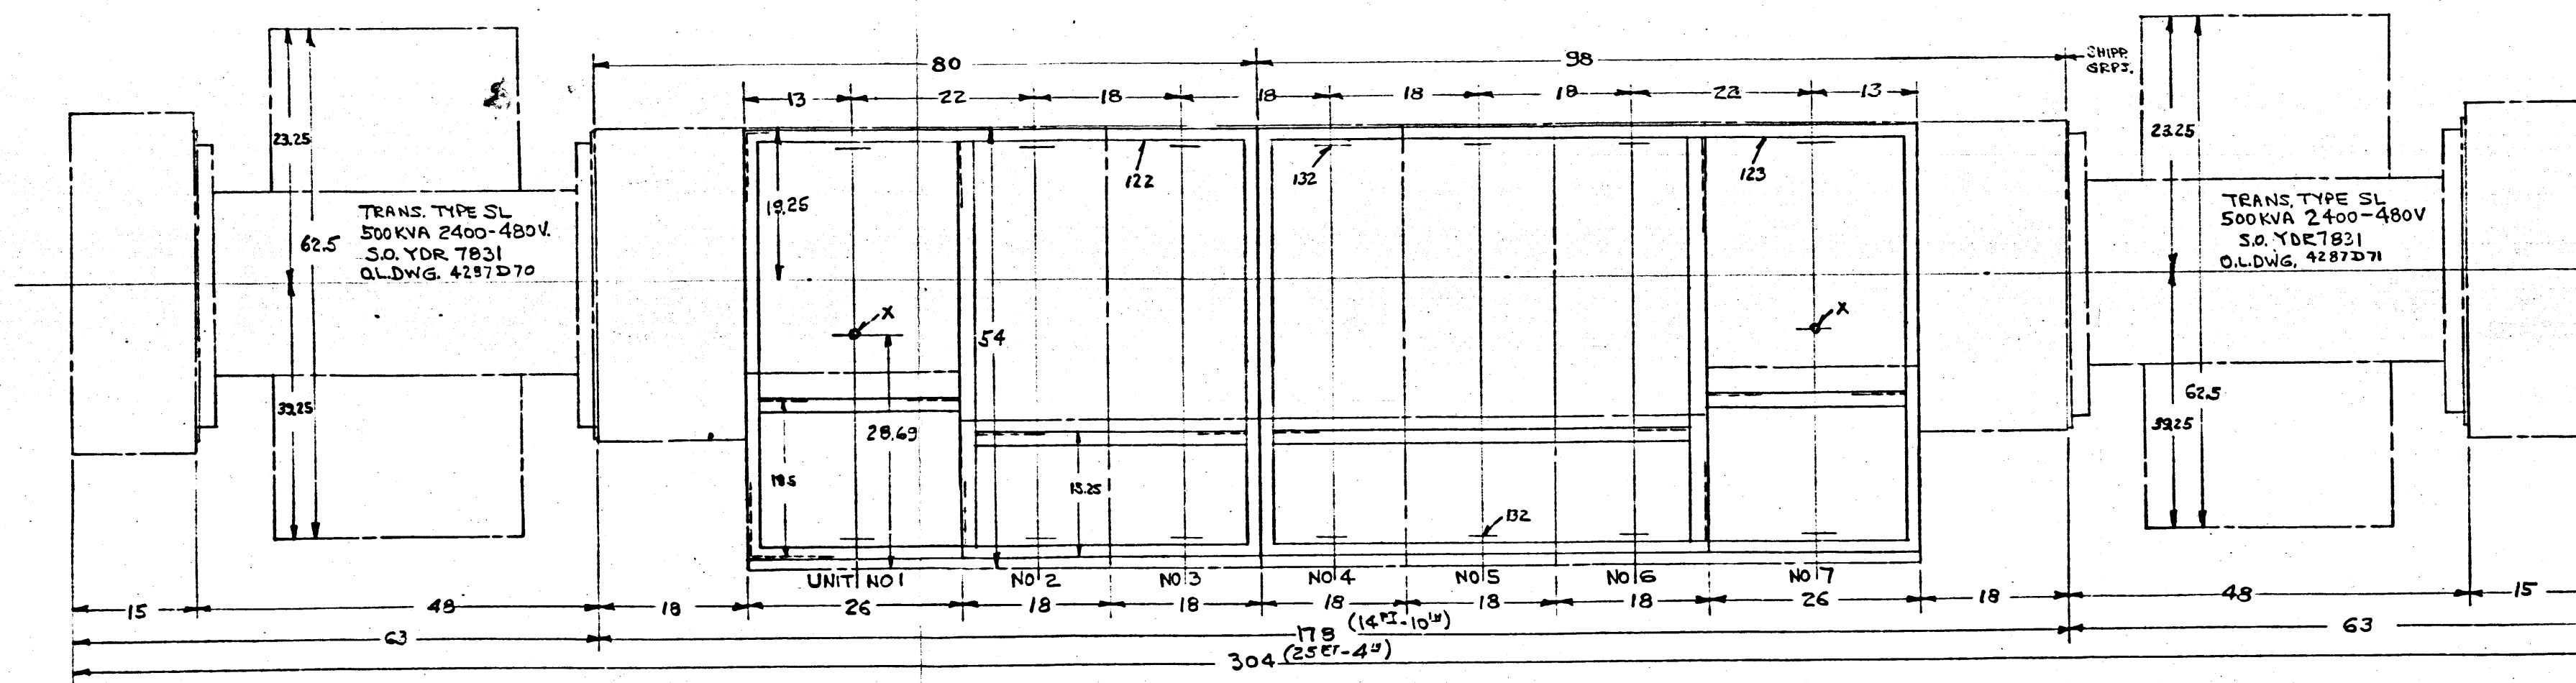X-1/8 TO 300MCM TERM. FOR
PURCHASERS CABLE CONN.
TO GRD.




SO	24Y4120	1
G.O.	OM12759-UM2	
IT.	CHANGE	
	EP17192	
	SO24Y4120	2
	TRANS. REP.	
	UNWG ADDED.	
	RLH 9-27-66	
	38B 10-6-66	
	2-X Memo L-10-7-66	
	EP17340	


[illegible]

500-A-583

SUB.	S.O.C. CODE	D.	REVISION	DATE	BY	APP.
1						
2						
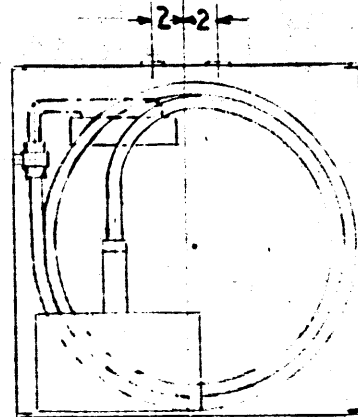

VIEW AA

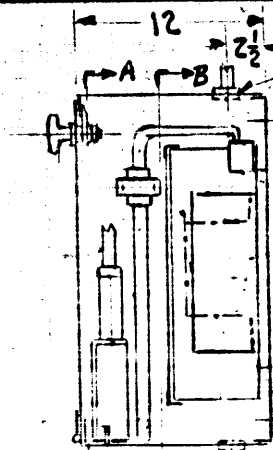

SECTIONAL SIDE VIEW


K.O. FOR 1 OR 1 1/4 CONDUIT
IN TOP & BOTTOM OF CABINET

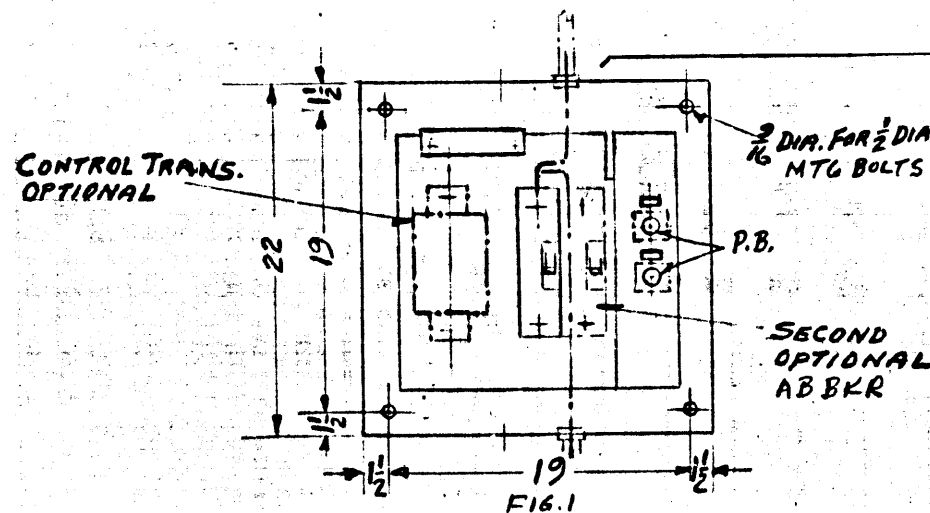FIG. 1

VIEW B-B

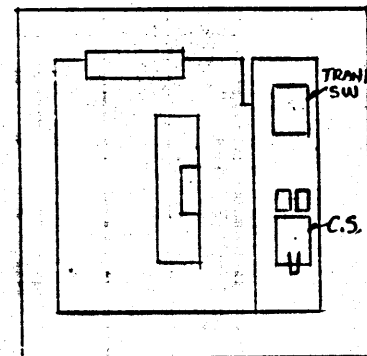


FIG. 2

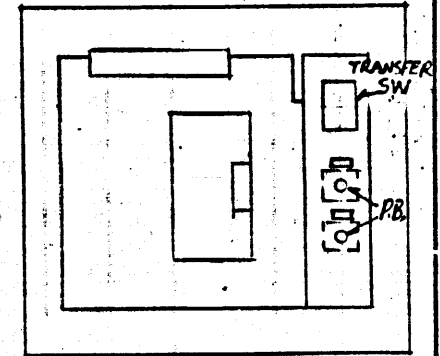


FIG. 3

DING. . DWG. 500A 613
GEN. ASSY DWG. 310C 307DIVISION **AS&D** WESTINGHOUSE ELECTRIC CORPORATIONPLANT LOCATION **EAST PITTSBURGH PA**SUB. **1**TITLE **LOW VOLTAGE METAL ENCLOSED SWGR.-TEST CABINET OUTLINE ASS'Y** DIM. IN INCHES N T S**50-0A583**

FORM 31950


6600

WESTINGHOUSE ELECTRIC CORPORATION	
TITLE: <u>HASTINGS UTILITIES</u>	<u>HASTINGS, NEBRASKA</u>
<u>LYME SWGR</u>	
<u>480V 3Ø 60W</u>	<u>ONE LINE & SCHEMATIC</u>
DWG# <u>243B-DISE</u>	<u>588F267</u>
DIVISION <u>SWGR</u>	PLANT LOCATION <u>EAST PITTSBURGH, PA 15300</u>
<u>2</u>	<u>1</u> FORM <u>243B-B</u>




588F268

NOTES:

- ▲ — ALARM SWITCH CONTACTS OPERATE, WHEN BREAKER IS TRIPPED AUTOMATICALLY BY ONE OF THE FOLLOWING ATTACHMENTS, SERIES OVERLOADS, UNDERVOLTAGE, OR REVERSE CURRENT TRIP. CONTACTS DO NOT OPERATE WHEN BREAKER IS TRIPPED MANUALLY OR BY THE SHUNT TRIP.
CONTACTS SHOWN IN THE RESET POSITION.
- — CELL SWITCH SHOWN WITH BREAKER IN TEST OR WITHDRAWN POSITION.
- — TERMINAL POINT FOR REMOTE CONNECTIONS.
- — REMOTE EQUIPMENT
- — FUTURE EQUIPMENT

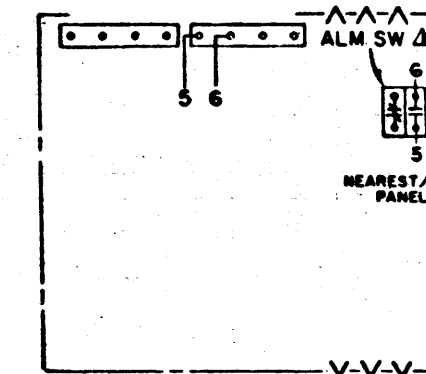
FIG-4 CONN DIAG (FV)
DB-15 MAN. OPR.DB-50 BREAKER
OPERATION SEQUENCE

- CONTROL SWITCH CS-C CLOSED.
 - "X" RELAY PICKS UP & SEALS IN THRU AUX. CONTACT "X".
 - CLOSING COIL ENERGIZED THRU "X" CONTACT, CLOSING BREAKER.
 - IN CLOSING, BKR. CLOSING MECH. MECHANICALLY UNLATCHES "X" CONTACTS FREE OF "X" ARMATURE INTERRUPTING CLOSING CIRCUIT.
 - WITH BREAKER IN CLOSED POSITION, THE BREAKER MECH. IS LATCHED CLOSED BUT "X" CONTACTS REMAIN UNLATCHED FROM "X" ARMATURE.
 - WHEN BKR. IS TRIPPED, CLOSING MECH. DROPS, PERMITTING "X" LATCH TO RESET PROVIDED "X" COIL IS DE-ENERGIZED.
- CC - CLOSING COIL
TC - TRIPPING COIL
X - CONTROL RELAY

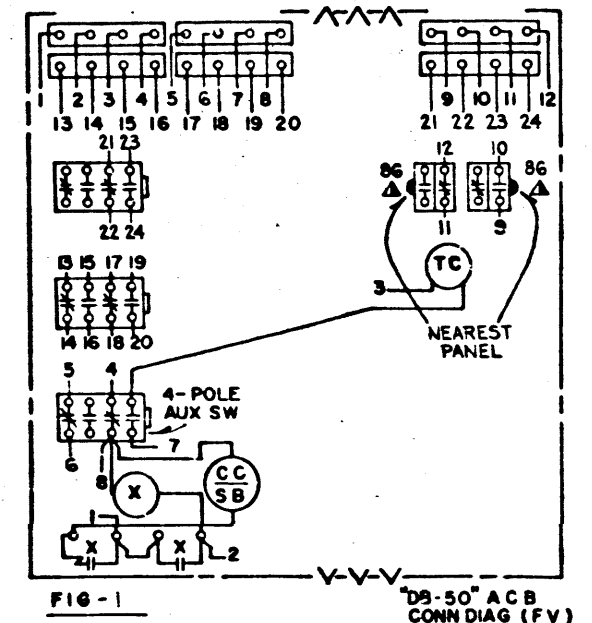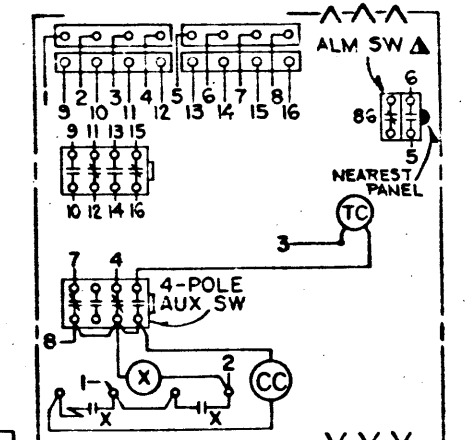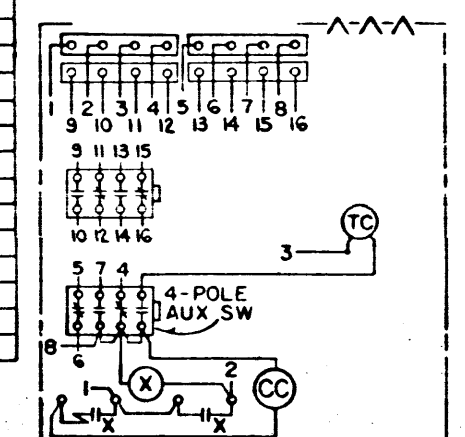FIG-1 DB-50 ACB
CONN DIAG (FV)FIG-2 CONN DIAG (FV)
DB-25 ACBFIG-3 CONN DIAG (FV)
DB-15 ACB

LIST OF APPARATUS		
IDENT	TYPE	DESCRIPTION
CS	W-2	CONTROL SWITCH
VS	W-2	VOLTMETER SWITCH
V	KA-241	VOLTMETER
A	KA-241	AMMETER
227	CV-7	UNDERVOLTAGE RELAY
227S	SG	UNDERVOLTAGE RELAY
227X	MG-6	AUX TO DEVICE 227
33		CELL SWITCH
435	W-2	CONTROL SELECTOR SWITCH
437	W-2	TRANSFER SWITCH
252TS	DB-50	MAIN AIR CKT BKR
252BT	DB-25	THE AIR CKT BKR
74	SG	ALARM RELAY FOR POWER FAILURE
86		ALM SW USED FOR OVERCURRENT LOCKOUT

DWG REF LIST		
FRONT VIEW	DWG	134D249
SECTIONS	DWG	134D250
BILL / MTL	DWG	134D251
FLOOR PLAN	DWG	134D252
HP CHART	DWG	134D253
ONE LINE SCHEMATIC	DWG	588F267
CONN DIAG UNIT 1	DWG	588F268
CONN DIAG UNIT 2-3	DWG	588F269
CONN DIAG UNIT 4	DWG	588F270
CONN DIAG UNIT 5-6	DWG	588F271
CONN DIAG UNIT 7	DWG	588F272
CONN DIAG UNIT 8	DWG	588F273

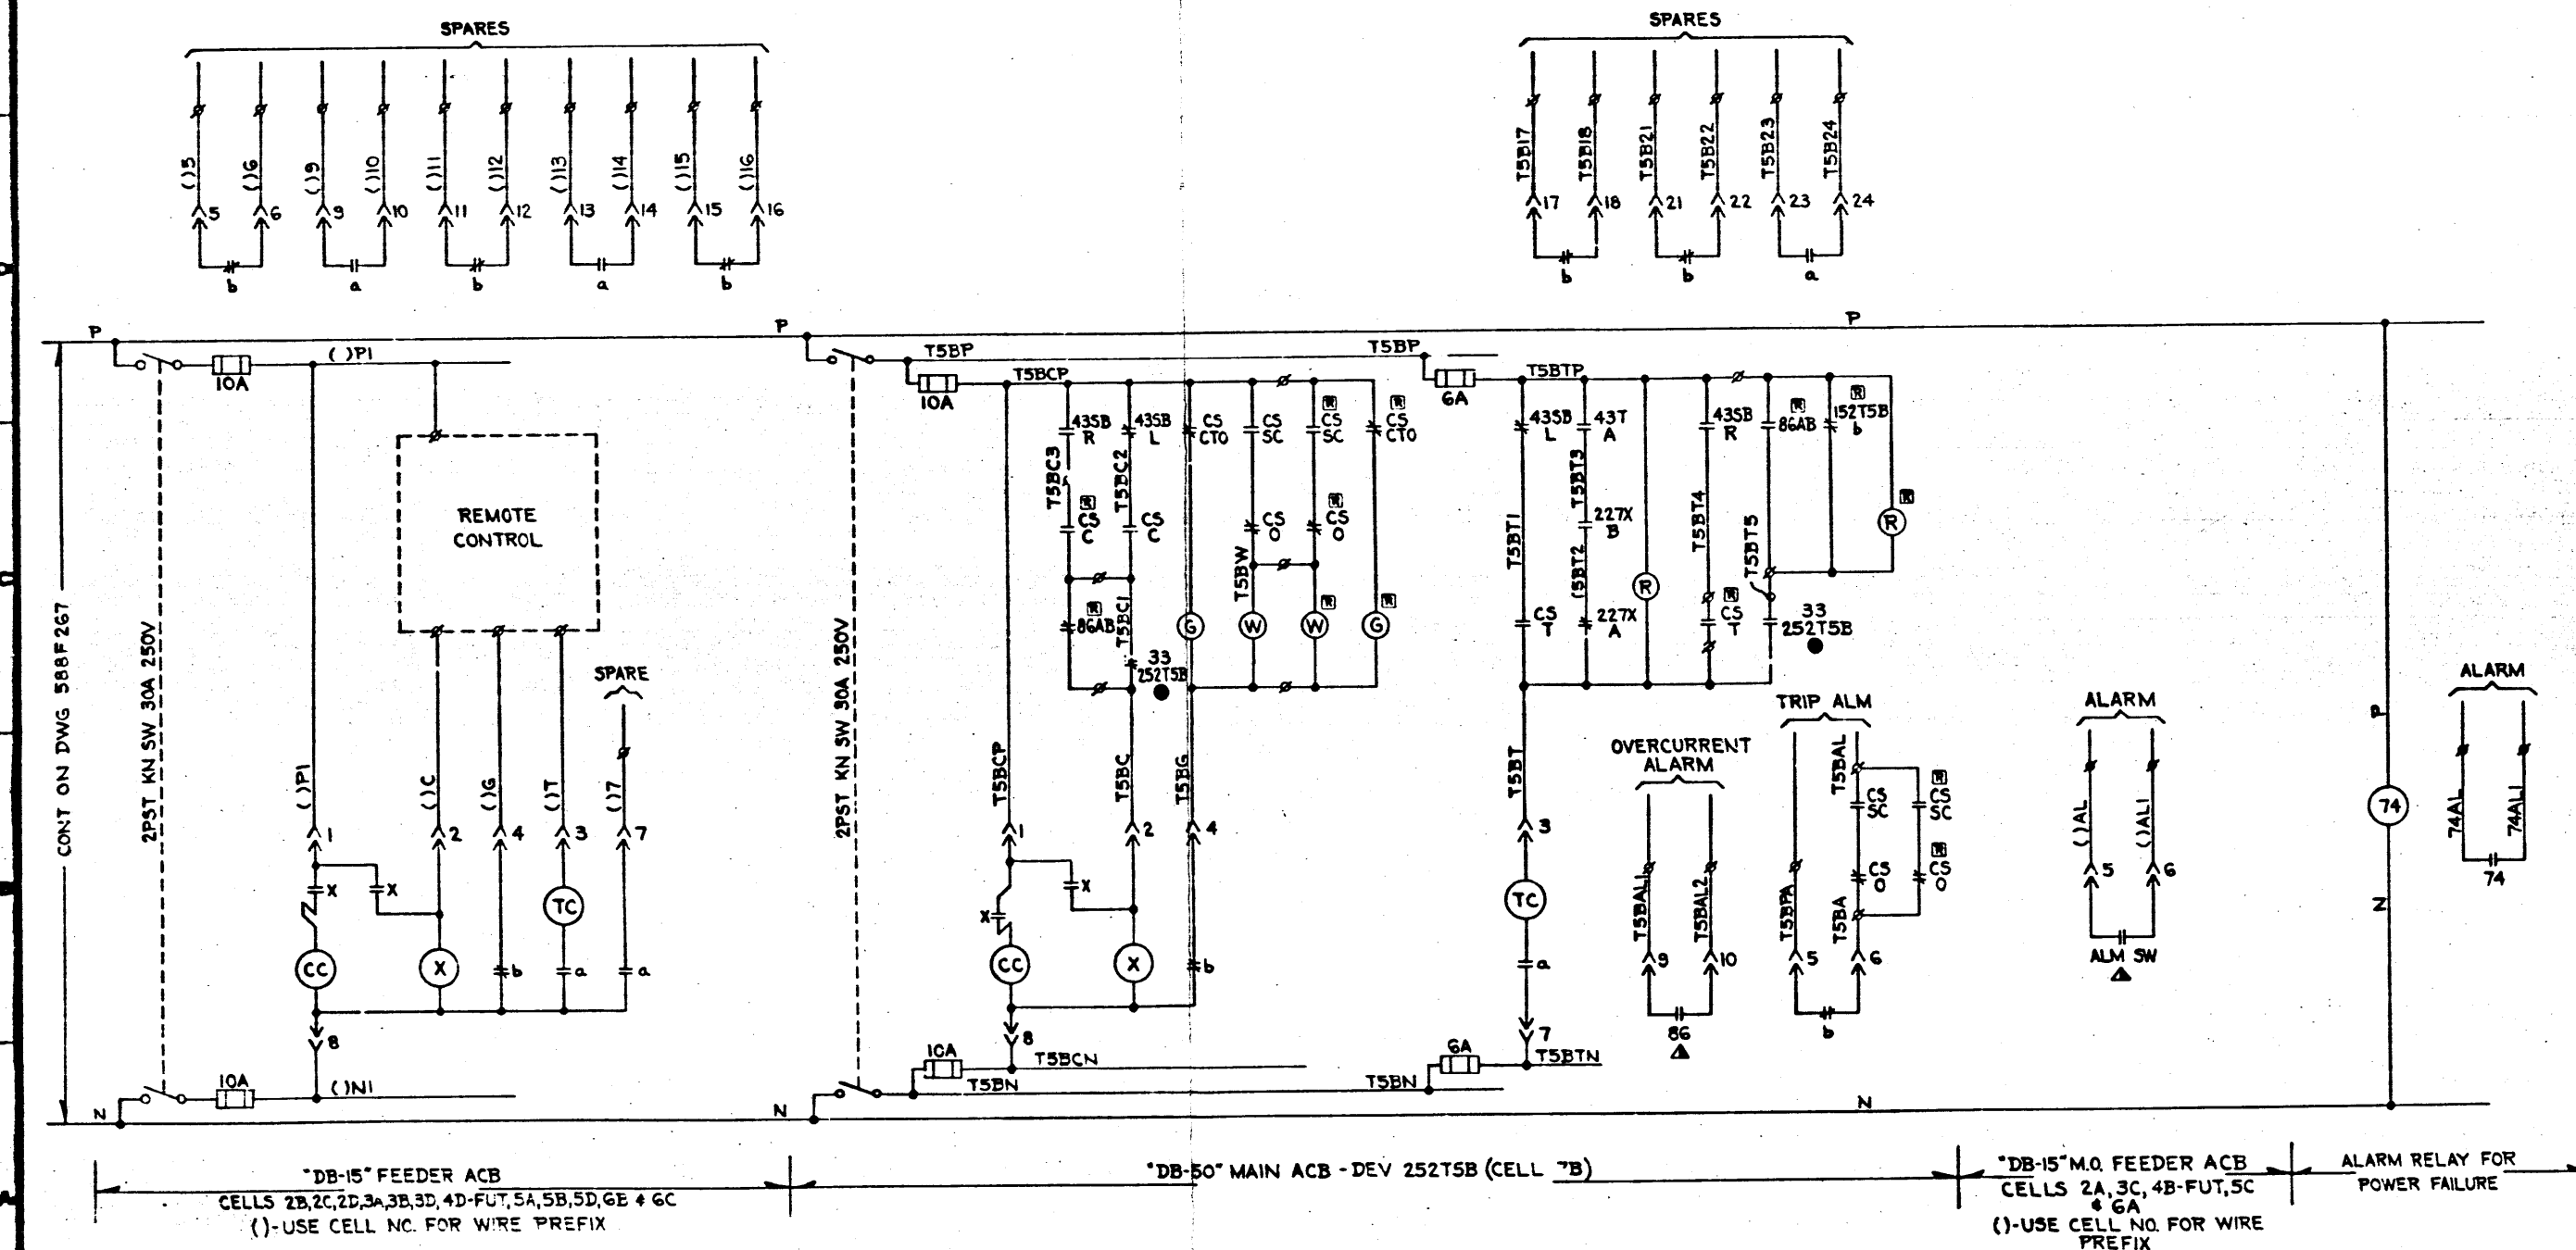

NOTE TO CUSTOMER

MATERIAL SUPPLIED BY WESTINGHOUSE ELECTRIC CORPORATION IS ACCORDING TO CONTRACT AND NOT MODIFIED BY ANYTHING SHOWN ON THIS DIAGRAM. LOCATION OF APPARATUS, WIRES OR CABLES MUST NOT BE DETERMINED FROM DIAGRAM.


PANEL CONNECTIONS SHOWN AS VIEWED FROM REAR EXCEPT AS NOTED. AUXILIARY SWITCHES AND CONTACTS SHOWN FOR OPEN, OFF OR DE-ENERGIZED POSITION OF MAIN DEVICES.

CURRENT AND POTENTIAL TRANSFORMER SYMBOLS SHOW TERMINALS OF THE SAME INSTANTANEOUS POLARITY AS INDICATED AT THE RIGHT.

CONNECTIONS ARE FOR PHASE ROTATION 1-2-3.

ALL CONNECTIONS MADE WITH #14 STRANDED WIRE, EXCEPT AS INDICATED.

WESTINGHOUSE ELECTRIC CORPORATION	
HASTINGS UTILITIES HASTINGS, NEBRASKA	
TITLE: LVNE SWGR	SCHEMATIC
480V 3Ø 60W	588F268
DIVISION: SWGR	PLANT LOCATION: EAST PITTSBURGH, PA 15100
FORM 2A35-B	

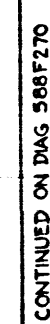


ENG DEPT REF-588F268

WESTINGHOUSE ELECTRIC CORPORATION			
HASTINGS UTILITIES		HASTINGS, NEBRASKA	
TITLE		LIVE SWGR	
480V 3P 60W		CONN DIAG	UNIT
SFTS: GC KUNDIRK			588F269
FPP RPA			
DIVISION SWGR		PLANT LOCATION EAST PITTSBURGH, PA	
2		1	FORM 2A35-B



WESTINGHOUSE ELECTRIC CORPORATION			
TITLE: WESTINGHOUSE		WESTINGHOUSE	
LIVE SWGR			
450/ 37 604		CON. DIAG	
DFTM: 10002000		588F270	
DIVISION: SWGR		PLANT LOCATION: EAST PITTSBURGH, PA	
2		1 FORM 2435-H	

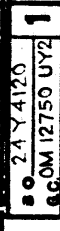

ENG DEPT REF-588F268

NOTE TO CUSTOMER

MATERIAL SUPPLIED BY WESTINGHOUSE ELECTRIC CORPORATION IS ACCORDING TO CONTRACT AND NOT MODIFIED BY ANYTHING SHOWN ON THIS DIAGRAM. LOCATION OF APPARATUS, WIRES OR CABLES MUST NOT BE DETERMINED FROM DIAGRAM.


PANEL CONNECTIONS SHOWN AS VIEWED FROM REAR EXCEPT AS NOTED. AUXILIARY SWITCHES AND CONTACTS SHOWN FOR OPEN, OFF OR DE-ENERGIZED POSITION OF MAIN DEVICES.


CURRENT AND POTENTIAL TRANSFORMER SYMBOLS SHOW TERMINALS OF THE SAME INSTANTANEOUS POLARITY INDICATED AT THE RIGHT.


CONNECTIONS ARE FOR PHASE ROTATION 1-2-3.
ALL CONNECTIONS MADE WITH #14 STRANDED WIRE, EXCEPT AS INDICATED.



WESTINGHOUSE ELECTRIC CORPORATION			
HASTINGS UTILITIES		HASTINGS, NEBRASKA	
TITLE LUME SGR			
480V 3F 60W		CONN DIAG	UN 4
OPTM: GCKUNDRI		588F271	
DIVISION SWGR		PLANT LOCATION: EAST PITTSBURGH, PA	

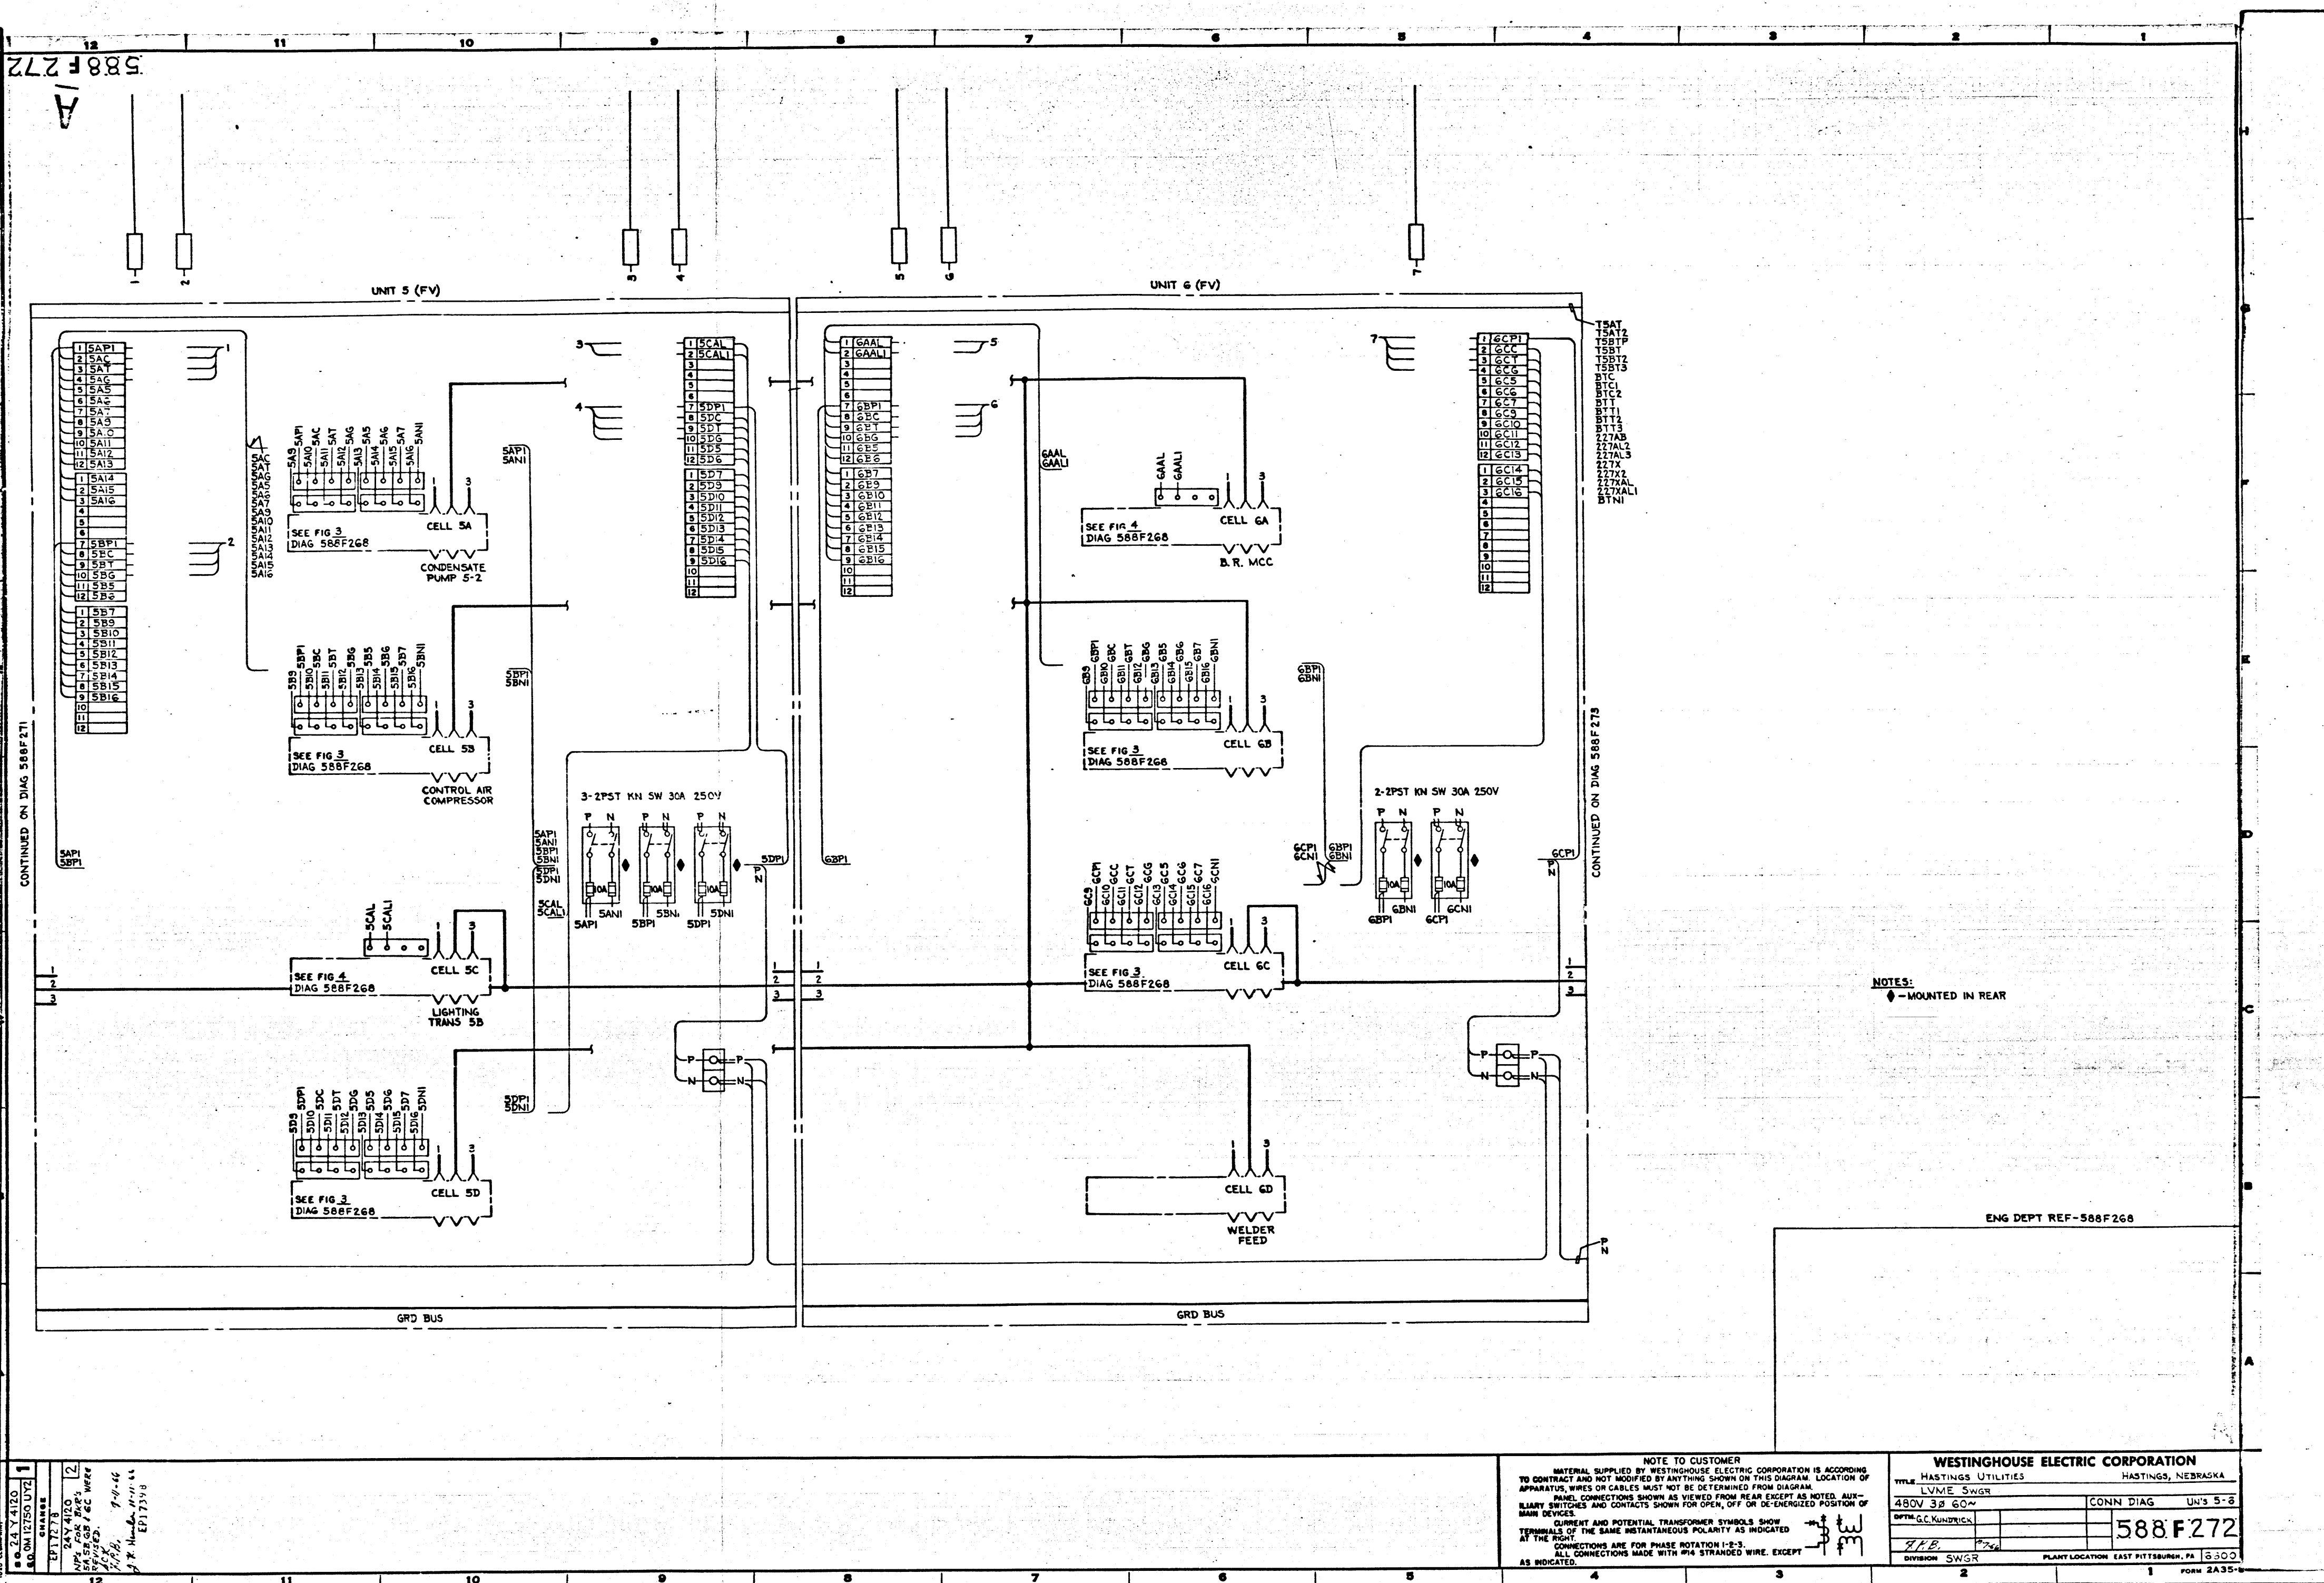

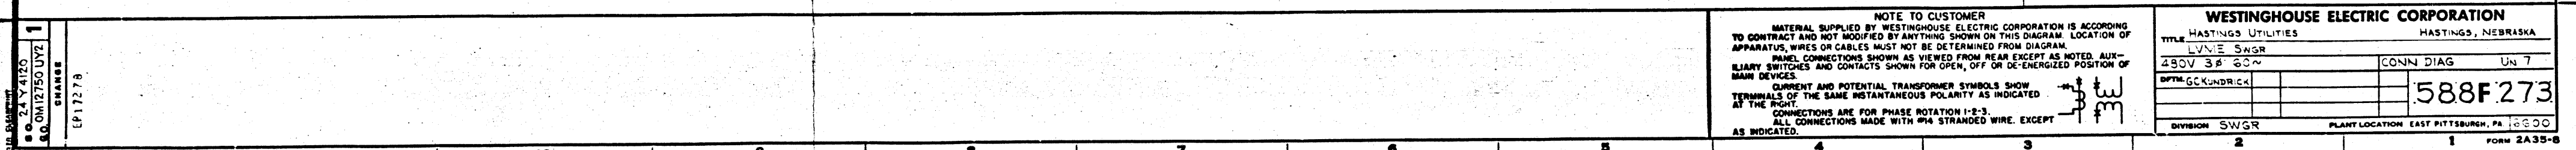

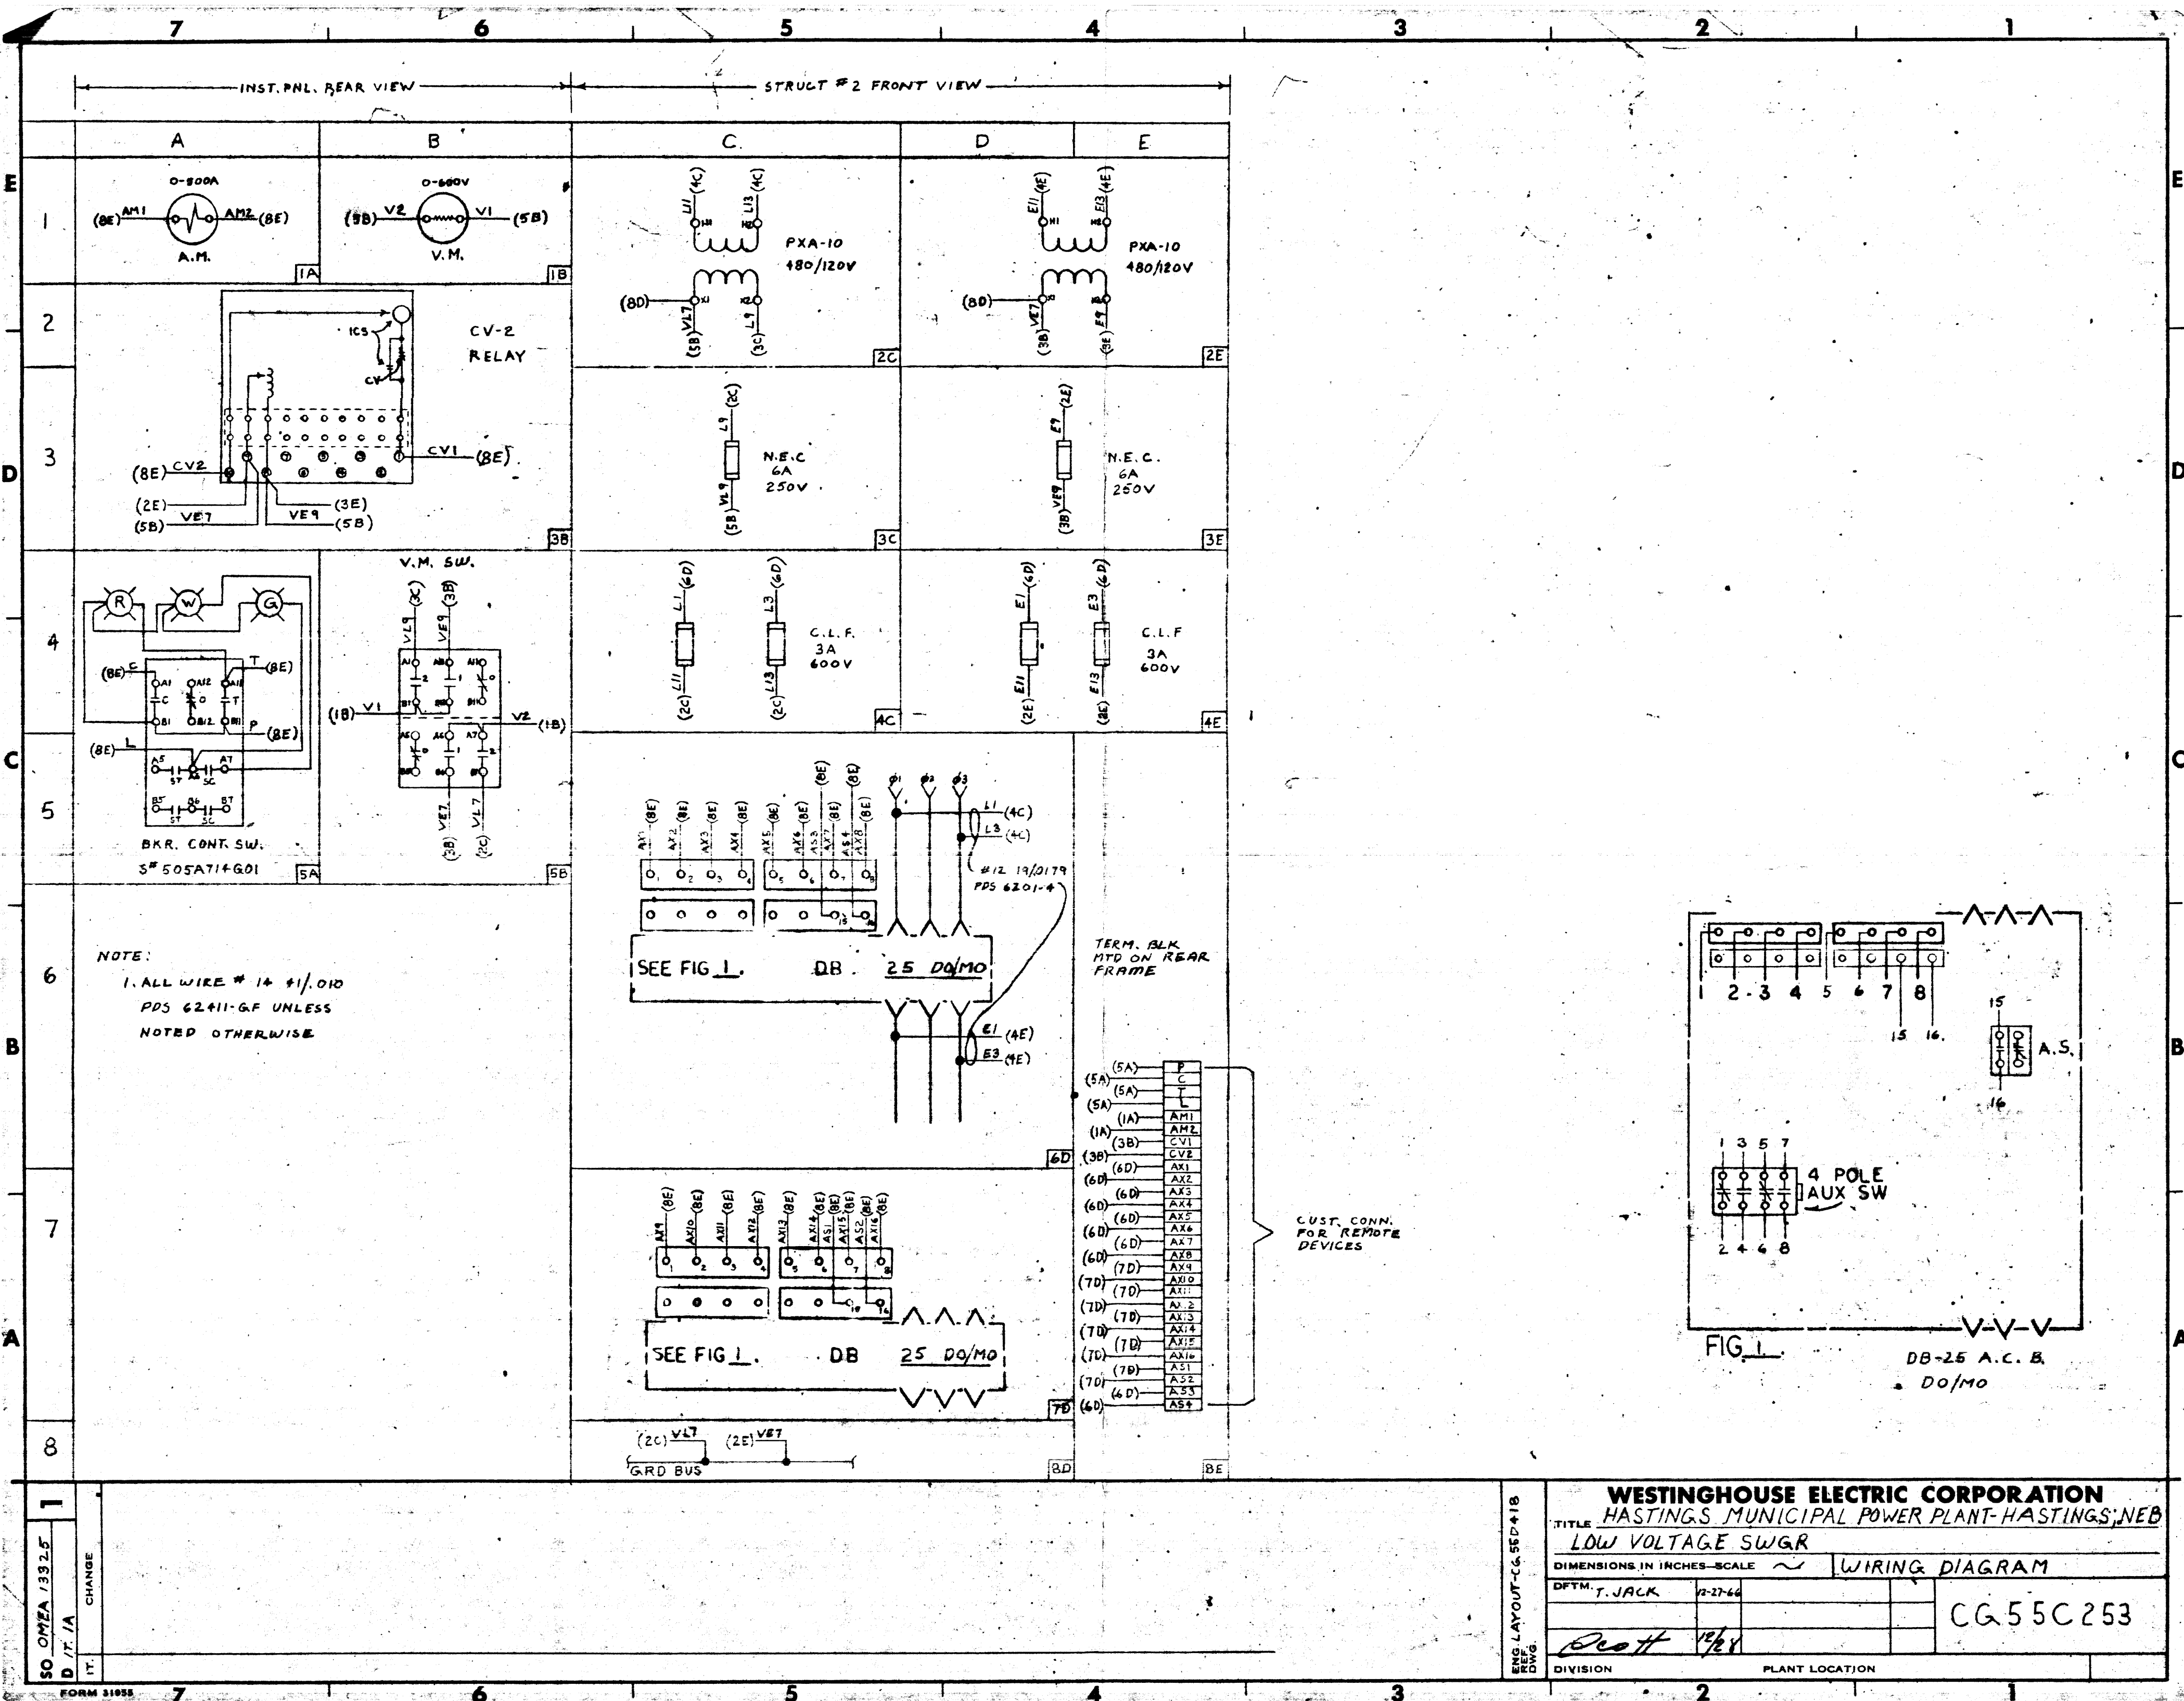

REV	DESCRIPTION	BY	DATE	REV	DESCRIPTION	BY	DATE	REV	DESCRIPTION	BY	DATE
A	ADDED CONTACTS TO PRD & LEVEL GAUGE, REMOVED CONTROL BOX, CORRECTED STUDS.	BB	11/20/13								

DESCRIPTION
1 LV BUSHING W/4 HOLE SPADE
4 HV BUSHING W/2 HOLE G SPADE
7 NAMEPLATES
8 RADIATOR
10 BOLTED HANDHOLE COVER
11 COVER LIFTING LUG
12 LIFTING LUG W/PULLING EYE
13 JACKING PROV. W/PULLING EYE
14 2 HOLE HORIZ NEMA GRD PAD
15 1 IN DRAIN VALVE AND SAMPLER
46 PRD/Q 208-60F W/CONTACTS
47 PRV VIAT 30206001N KRYTOX
48 THERMOMETER W/2 CONTACTS
49 4" MAG LL GAUGE W/CONTACTS
50 OIL LEVEL PLUG
51 TAP CHANGER HANDLE
52 1" UPPER FILTER VALVE
57 PRES VAC GAUGE W/PV REGULATOR
62 NITROGEN TEST-SCHRADER VALVE
64 2 INCH BALL VALVE
98 3/8" X 1" STUDS WELDED TO TANK FOR ATTACHING SHROUD
99 CENTER OF GRAVITY

APPROVAL DRAWING

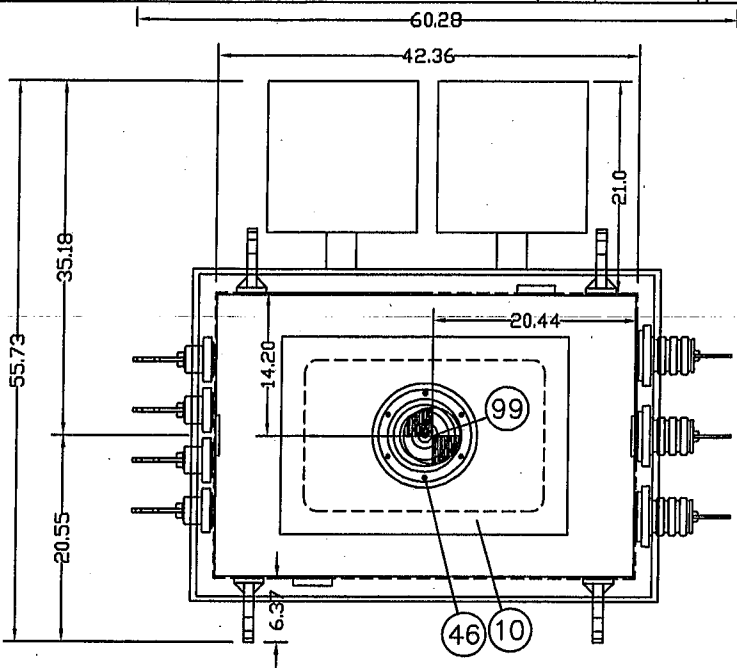
PLEASE INDICATE BY SIGNING

APPROVED _____ DATE _____




THIS DRAWING REPERESENTS THE
TRANSFORMER COVERED BY
YOUR SPECIFICATION

NO. _____ DATED _____
PLEASE RETURN TO HOWARD
INDUSTRIES.

NOTE: IF DISCREPANCIES APPEAR
PLEASE NOTE ON UNSIGNED
DRAWING AND RETURN



CUSTOMER :	DUTTON
SPEC.	DATED
KVA	500.0 BIL 60 TAPS TS-2 ABOVE 2 BELOW
HIGH VOLTAGE	2400
LOW VOLTAGE	480Y/277
APPROX. CORE AND COIL WEIGHT	2673
APPROX. TANK AND ACCESS. WEIGHT	940
GAL. OF OIL 202 , APPROX. WEIGHT	1516
APPROX. TOTAL WEIGHT	5129

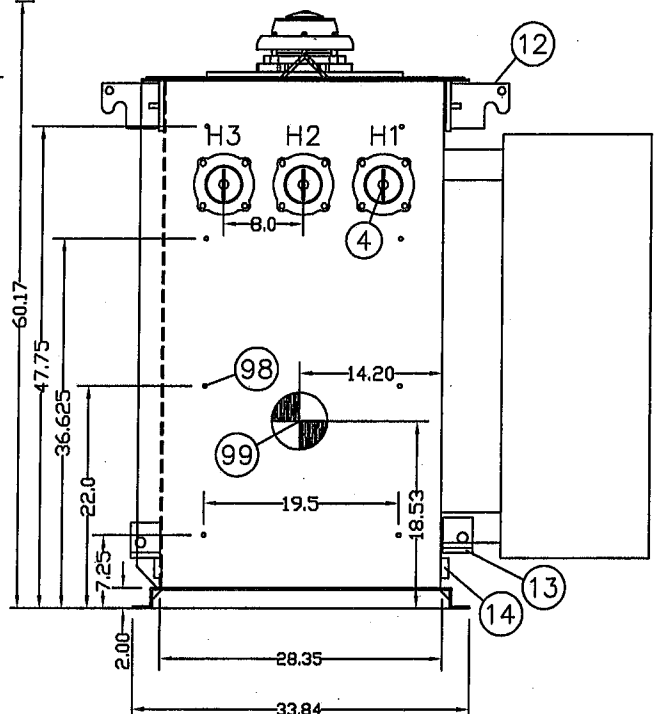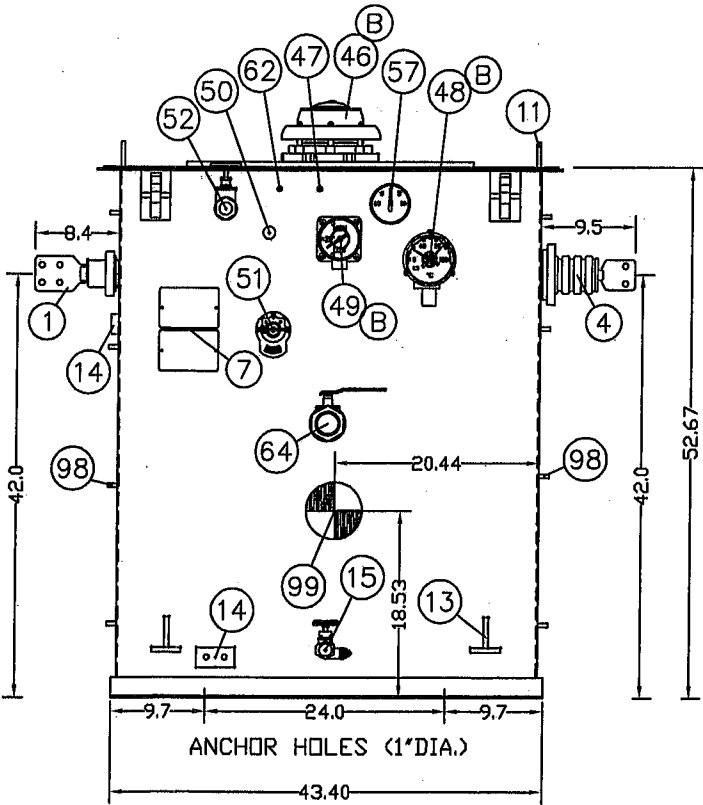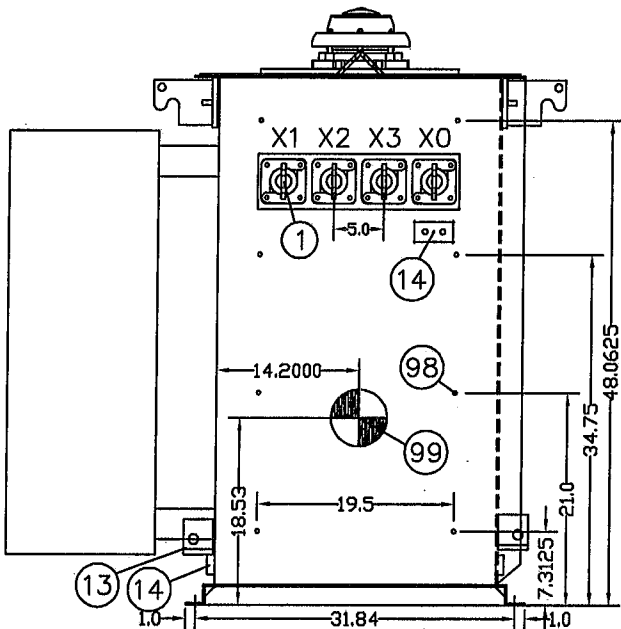

SPECIAL NOTES
A STAINLESS EXTERNAL HARDWARE
B 72" CONTROL CABLES ATTACHED, COILED AND TIED FOR USE
C
D
E NO RUNNERS OR PALLET PROVIDED

\$7SBC897

HOWARD INDUSTRIES INC.

LAUREL, MISS. USA 39440

MFG. OF DISTRIBUTION TRANSFORMERS

NAME: OUTLINE	CC 745
CAT. NO. 9985490014037	
ID. 3BCB9715	PN. 274042-00
SCALE 0.056	DWG BY BC
CHK BY	DATE 11/04/13

REV	DESCRIPTION	BY	DATE	REV	DESCRIPTION	BY	DATE	REV	DESCRIPTION	BY	DATE

READ INSTRUCTION MANUAL
HI 105 BEFORE OPERATING
THREE PHASE TRANSFORMER
CLASS KNAN

HOWARD INDUSTRIES

ELLISVILLE, MS
USA
DOE COMPLIANT

60 HERTZ
65 °C RISE

%IMP

KVA 500
HV 2400
LV 480Y/277

LIQUID:ENVIROTEMP (FR3) CONTAINS LESS THAN 1 PPM PCB AT TIME OF MANUFACTURE
LIQUID LEVEL BELOW TOP OF MANHOLE FLANGE AT 25°C IS 7.00 INCHES. LIQUID
LEVEL CHANGES 0.29 INCHES PER 10° C CHANGE IN LIQUID TEMPERATURE.
MAXIMUM OPERATING PRESSURES OF LIQUID PRESERVATION SYSTEM 10 PSI POSITIVE
AND 8 PSI NEGATIVE. TANK SUITABLE FOR 7 PSI VACUUM FILLING

APPROXIMATE WEIGHTS

202 GALS. LIQ. 1516 LBS TANK AND FITTINGS 940 LBS
CORES & COILS 2673 LBS TOTAL 5129 LBS

SER. NO. BAR CODE CAT. NO. BAR CODE

SER. NO.

9985490014037
P.N. 0061200829500

ACTUAL TESTED IMPEDANCE WILL BE
STAMPED AT TIME OF MANUFACTURE

DATE OF MANUFACTURE WILL BE
STAMPED AT TIME OF MANUFACTURE

APPROVAL DRAWING

PLEASE INDICATE BY SIGNING
APPROVED _____ DATE _____

THIS DRAWING REPRESENTS THE
TRANSFORMER COVERED BY
YOUR SPECIFICATION

NO. _____ DATED _____
PLEASE RETURN TO HOWARD
INDUSTRIES.

NOTE: IF DISCREPANCIES APPEAR
PLEASE NOTE ON UNSIGNED
DRAWING AND RETURN

HOWARD INDUSTRIES INC.

LAUREL, MISS. USA 39440

MFG. OF DISTRIBUTION TRANSFORMERS

NAME: LASER NAME PLATE	cc 857
CAT. NO. RF/TP/D-Y	
ID. 3BCB9736	PN. 61200829.500
PG 1 OF 2	SCALE 1.000
DWG BY BC	CHK BY
	DATE: 11/05/13

REV	DESCRIPTION	BY	DATE	REV	DESCRIPTION	BY	DATE	REV	DESCRIPTION	BY	DATE

READ INSTRUCTION MANUAL
HI 105 BEFORE OPERATING

HOWARD INDUSTRIES

ELLISVILLE, MS
USA

H.V. WINDING CONNECTIONS			
VOLTAGE H1-H2-H3	500 KVA AMPS	TAP	CONNECTS
2520	114.6	1/A	2 TO 3
2460	117.3	2/B	3 TO 4
2400	120.3	3/C	4 TO 5
2340	123.4	4/D	5 TO 6
2280	126.6	5/E	6 TO 7

HV

CU

LV

CU

L.V. WINDING CONNECTIONS	
VOLTS X1-X2-X3	500 KVA AMPS
480	601

BIL LEVELS

HV WINDING 60 KV

LV WINDING 30 KV

SER. NO. BAR CODE

CAT. NO. BAR CODE

9985490014037

P.N. 0061200830500

SER. NO.

LVBLOC = (S2) LV SEG. BLOCK
CPN11 = (11G) LVB BLOCK
CPHAS1 = (WYE) LV PHASE

HVBLOC = (S4) HV SEG. BLOCK
CNP2 = (2N) HVB BLOCK
CPHAS2 = (DEL) HV PHASE

CODE5 = (S) TAP CODE

APPROVAL DRAWING
PLEASE INDICATE BY SIGNING
APPROVED _____ DATE _____
THIS DRAWING REPRESENTS THE
TRANSFORMER COVERED BY
YOUR SPECIFICATION
NO. _____ DATED _____
PLEASE RETURN TO HOWARD
INDUSTRIES.
NOTE: IF DISCREPANCIES APPEAR
PLEASE NOTE ON UNSIGNED
DRAWING AND RETURN

REV	DESCRIPTION	BY	DATE	REV	DESCRIPTION	BY	DATE	REV	DESCRIPTION	BY	DATE



APPROVAL DRAWING

PLEASE INDICATE BY SIGNING
APPROVED _____ DATE _____

THIS DRAWING REPRESENTS THE
TRANSFORMER COVERED BY
YOUR SPECIFICATION


NO. _____ DATED _____
PLEASE RETURN TO HOWARD
INDUSTRIES.

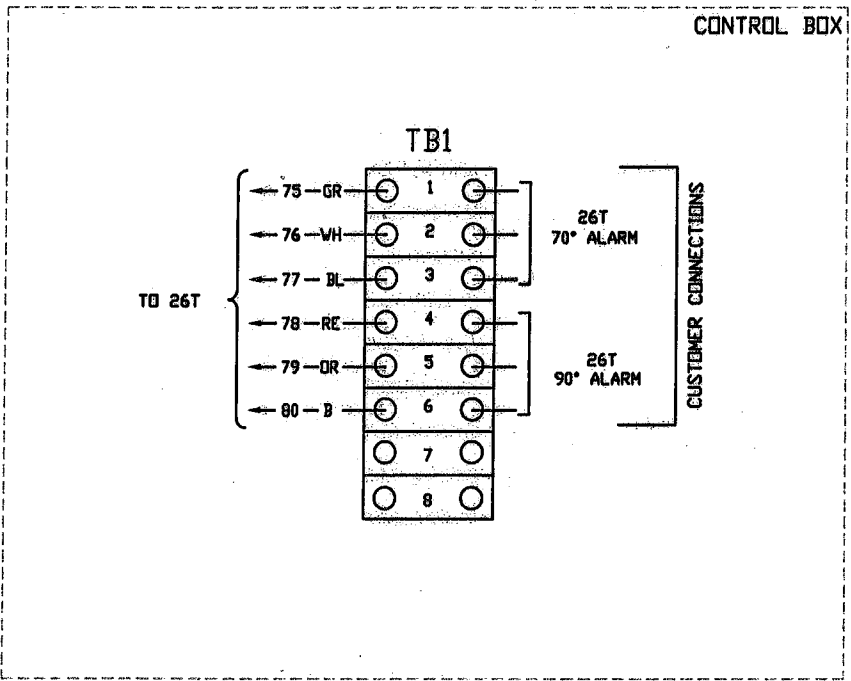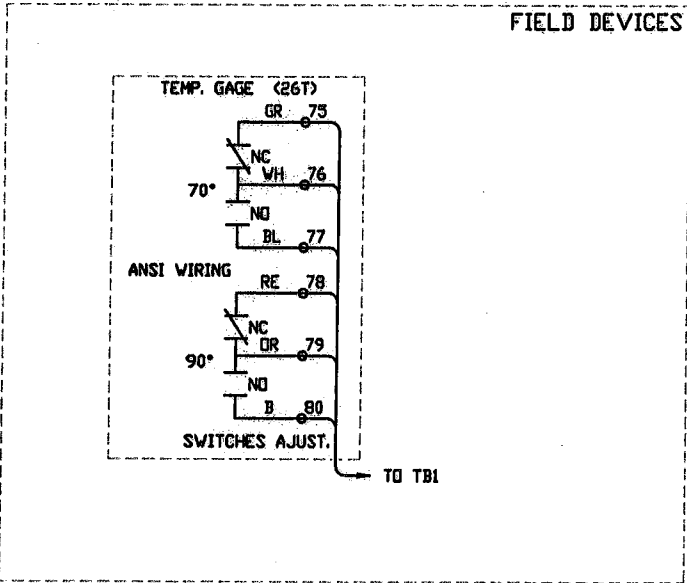NOTE: IF DISCREPANCIES APPEAR
PLEASE NOTE ON UNSIGNED
DRAWING AND RETURN



1: 26T, THERMOMETER GAGE

- |— NORMALLY OPEN
—|/— NORMALLY CLOSED
⊗ TERMINAL BLOCK
- VH - WHITE
GR - GREEN
BL - BLACK
OR - ORANGE
- RE - RED
B - BLUE
YL - YELLOW
BN - BROWN
PU - PURPLE

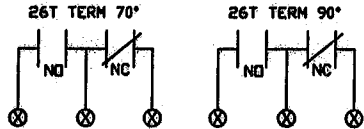

GAGE CONTACT SCHEMATIC

TERMINAL BLOCK SPECS: 600V, 40A, 8-18AWG, 20 LB-IN TORQUE

HOWARD INDUSTRIES INC.

LAUREL, MISS. USA 39440

MFG. OF DISTRIBUTION TRANSFORMERS

PG 1 OF 1

PART NUMBER: 71754032.713

NAME: WIRING DIAGRAM

CC 719

DESCR: 9985490014037

SCALE NTS

DWG BY BC

CHK BY JS

DATE: 11/05/13